

HAR
G 42
10-30-62

WATER WELL DRILLERS LOG

G CODED

Date: Oct. 30, 1962, Driller: M+B Drilling Co. County Harrison

(Name)

(1) Owner of Land: Mr. Hampton
(Name)
Biloxi River Estates
(Address)

(2) Location: NW 1/4, NE 1/4, Sec. 36 T5R11W
3 1/2 miles East of Nugent
(distance) (direction) (Nearest Town)

(3) Topography: Hilly
(Hilly) (Flat) (Level)

(4) Purpose of Well: Domestic
(Domestic Irrigation
Municipal, Industrial, Other)

Description & Color of Materials Sand, Clay, Red Clay, Shell, etc.	Thick- ness Feet	Depth Feet
Red clay	26	26
White clay	56	82
Sand & Gravel	4	86
Blue Clay	98	184
Fine Sand	8	192
Blue Clay	84	276
Coarse Grey Sand	14	290
Blue Clay 290 on		

Information upon completion of well:

(1) Diameter: 2 inches.

(2) Total Depth: 288 feet.

(3) Water Level: 31 feet below top of ground.

(4) Cased to: 282, Size 2"

(5) Screen: Size 2" x 1/8" slot, Length 6 FT.


(6) Were any formations sealed against pollution?
_____ yes _____ no.

CODED

If YES depth of formation _____

Why _____

Drillers Remarks _____

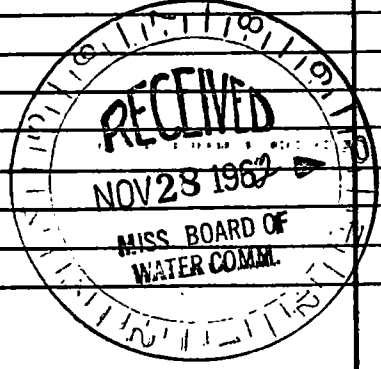

(Use Back Side)

Well No.

