

HAR.

MISSISSIPPI BOARD OF WATER COMMISSIONERS

G 43

1-7-63

WATER WELL DRILLERS LOG


**CODED**

G

Date: Jan 7, 1963, Driller: Joe Miller County Harrison  
(Name)

(1) Owner of Land:	Description & Color of Materials Sand, Clay, Red Clay, Shell, etc.	Thick- ness Feet	Depth Feet
<u>Chesler Wilson</u> (Name) <u>RR# Gulfport Miss</u> (Address)	<u>Surface</u>	8	8
(2) Location: <u>NE 1/4, SW 1/4, Sec. 36 T6S R11W</u> <u>6</u> miles <u>North East</u> , of <u>Gulfport</u> (distance) (direction) (Nearest Town)	<u>White Sand</u>	14	22
(3) Topography: <u>Hilly</u> (Hilly) (Flat) (Level)	<u>Pink Clay</u>	5	27
(4) Purpose of Well: <u>Domestic</u> (Domestic Irrigation Municipal, Industrial, Other)	<u>Red Sand</u>	8	35
Information upon completion of well:	<u>Pink Clay</u>	3	38
(1) Diameter <u>2</u> inches.	<u>Rock (No. 6 Hb)</u>	1	39
(2) Total Depth <u>516'</u> feet.	<u>Pink Clay</u>	3	42
(3) Water Level _____ feet below top of ground.	<u>Blue Mud, Wood, Bra. Sd.</u>	11	53
(4) Cased to <u>504</u> , Size <u>2"</u>	<u>Brown Sand</u>	28	81
(5) Screen: Size <u>2"</u> , Length <u>10'</u>	<u>White Clay</u>	21	101
(6) Were any formations sealed against pollution? _____ yes, _____ no.	<u>Blue Clay</u>	231	332
If YES depth of formation _____	<u>Red</u> 7 (Chatter)	4	336
Why _____	<u>Hard Blue Clay</u>	109	445
Drillers Remarks: _____	<u>Sra Sand. (Fine)</u>	28	473
_____	<u>Sra Sand (Fair)</u>	41	514
_____	<u>Hard Blue Clay</u>	2	516
_____	_____	_____	_____
_____	_____	_____	_____

**CODED**

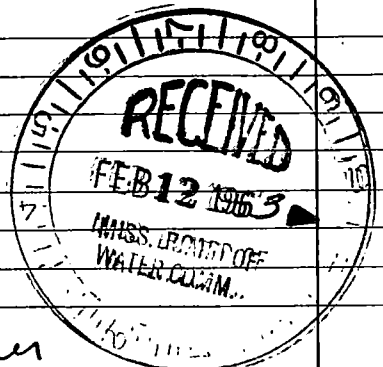

over

(Use Back Side)

Well No.

21000

4K4 49

Three Rivers Road

Holliman Rd.

well

Neal Road

Nogent

