

HAR.

G 44  
2-10-63

K392305

WATER WELL DRILLERS LOG

**CODED**

Date: Feb 10, 1963, Driller: Joe Miller County HARRISON

(Name)

(1) Owner of Land:	Description & Color of Materials Sand, Clay, Red Clay, Shell, etc.	Thick- ness Feet	Depth Feet
<u>Otis Fairley</u> (Name)	<u>Hard Red Clay</u>	<u>17</u>	<u>17</u>
<u>Lyman Miss</u> (Address)	<u>Red Sand</u>	<u>6</u>	<u>23</u>
(2) Location: _____ 1/4, _____ 1/4, Sec. <u>22</u> T. <u>6</u> R. <u>11</u>	<u>White Clay</u>	<u>57</u>	<u>80</u>
<u>1</u> miles <u>East</u> of <u>Lyman</u> (distance) (direction) (Nearest Town)	<u>Blue Clay</u>	<u>269</u>	<u>349</u>
(3) Topography: <u>Hilly</u> (Hilly) (Flat) (Level)	<u>Sand - Fine (Gray)</u>	<u>24</u>	<u>373</u>
(4) Purpose of Well: <u>Domestic</u> (Domestic Irrigation Municipal, Industrial, Other)	<u>Hard Blue Clay</u>	<u>22</u>	<u>395</u>
	<u>Break Sand Fine</u>	<u>16</u>	<u>411</u>
	" " "	<u>10</u>	<u>421</u>
	" " <u>Fair</u>	<u>11</u>	<u>432</u>
	" " <u>Good</u>	<u>43</u>	<u>475</u>

Information upon completion of well:

- (1) Diameter 2" inches.
- (2) Total Depth 495' feet.
- (3) Water Level 44' feet below top of ground.
- (4) Cased to 465', Size 2"
- (5) Screen: Size 2", Length 10'
- (6) Were any formations sealed against pollution?  
\_\_\_\_\_ yes, \_\_\_\_\_ no.


If YES depth of formation \_\_\_\_\_

Why \_\_\_\_\_

Drillers Remarks: \_\_\_\_\_

*Still in sand*

**CODED**

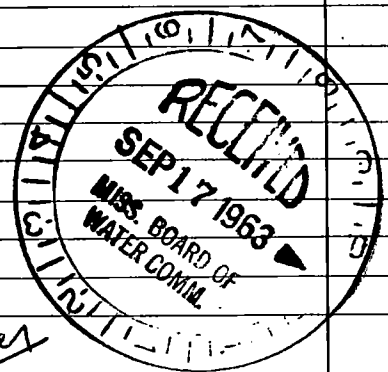


*over*

(Use Back Side)

Well No.

01/11/99

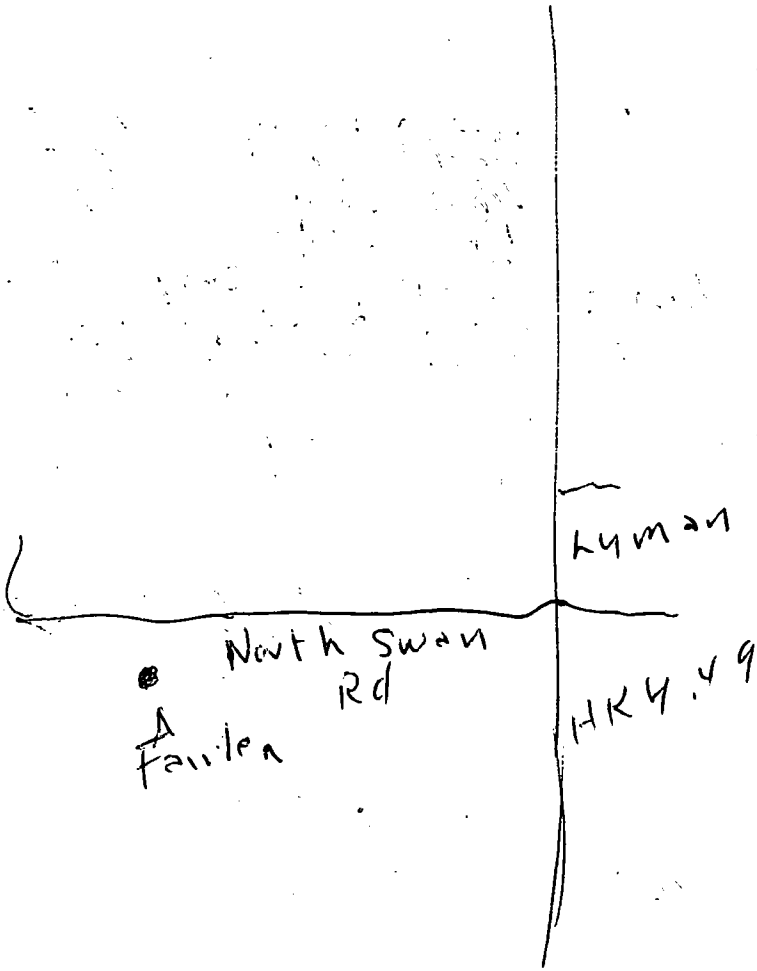

HKY.49