

HAR.

G45

\$393307

WATER WELL DRILLERS LOG

¹²
CODED

Date: Feb 27, 1963 Driller: Joe Miller County Harrison

(Name)

(1) Owner of Land: J.M. Clifton
(Name)

Lyman Miss
(Address)

(2) Location: 1/4, 1/4, Sec. 29 6 11 T R

1/4 miles East, of Lyman
(distance) (direction) (Nearest Town)

(3) Topography: Flat
(Hilly) (Flat) (Level)

(4) Purpose of Well: Domestic
(Domestic Irrigation
Municipal, Industrial, Other)

Description & Color of Materials Sand, Clay, Red Clay, Shell, etc.	Thick- ness Feet	Depth Feet
Brown & Red Clay		18
Blue Clay	102	120
Break, Fine Sand	8	128
Blue Clay	107	235
Break, Fine Sand	6	241
Break-Sand-Fair	7	248
Blue Clay	89	337
Sand-Fair	10	347
Sand-Finer	6	353
Blue Clay	57	410
Break Fine Sand	10	420
" " "	11	431
" Fair "		441
" Good "	43	484
" Real Good "	18	502
Hard Blue-Clay	1	503

Information upon completion of well:

(1) Diameter 2" inches.

(2) Total Depth 503' feet.

(3) Water Level 31' feet below top of ground.

(4) Cased to 492, Size 2"

(5) Screen: Size 2", Length 10"


(6) Were any formations sealed against pollution?
_____ yes, _____ no.

If YES depth of formation _____

Why _____

Drillers Remarks: _____

CODED

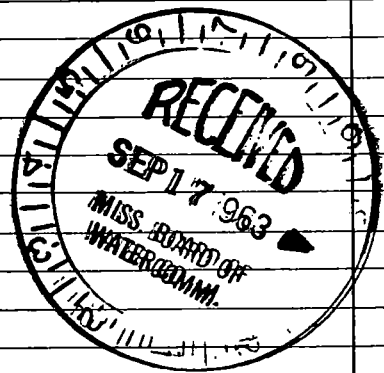

(Use Back Side)

Well No.

