

HAR.

G 48

u342001

WATER WELL DRILLERS LOG

CODED

Date: Aug 2, 1963, Driller: Joe Miller County: Harrison

8-2-63

(Name)

(1) Owner of Land: Carroll Peterman

(Name)

Lyman Miss

(Address)

(2) Location: 1/4, 1/4, Sec. 29 6 11 T R

0

miles (distance)

(direction)

of Lyman (Nearest Town)

(3) Topography: Hilly

(Hilly)

(Flat)

(Level)

(4) Purpose of Well: Domestic

(Domestic Irrigation, Municipal, Industrial, Other)

Description & Color of Materials
Sand, Clay, Red Clay, Shell, etc.

Thick-
ness
Feet

Depth
Feet

Surface	5	5
Brown Clay	15	20
Blue Clay	178	198
Sand - Gray, Fine	33	231
Sand, " Little Bells	182	49
Clay Blue - Hard	6	310
Sand, " N & Fine	20	330
Clay, Blue Hard	95	425
Sand, Gray - Fair	17	442
Sand " Good	11	453
" " Real Good	17	470
" " Finer	10	480

Information upon completion of well:


- (1) Diameter 2" inches.
- (2) Total Depth 480' feet.
- (3) Water Level 55' feet below top of ground.
- (4) Cased to 460', Size 2"
- (5) Screen: Size 2", Length 10'
10' Tail Pipe
- (6) Were any formations sealed against pollution?
_____ yes, _____ no.

If YES depth of formation _____

Why _____

Drillers Remarks: _____

CODED

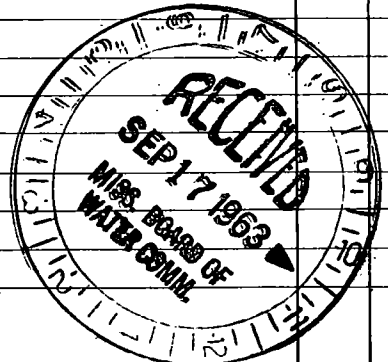

(Use Back Side)

Well No.



Handwritten text at the top right, possibly a title or date.

Handwritten text below the top right, possibly a name or location.

Handwritten text in the middle right section.

Handwritten text below the middle right section.

Handwritten text at the bottom right of the middle section.

