

HAR.

MISSISSIPPI BOARD OF WATER COMMISSIONERS

G50

9-25-63

WATER WELL DRILLERS LOG

**CODED**

Date: 9-25, 1963, Driller: Joe Miller County Harrison  
(Name)

(1) Owner of Land: Bell Sauer  
(Name)  
RR# Sauer Miss  
(Address)

(2) Location: NW 1/4, SW 1/4, Sec 88 T6R11W  
12 miles North, of Suffolk  
(distance) (direction) (Nearest town)

(3) Topography: Hilly  
(Hilly) (Flat) (Level)

(4) Purpose of Well: Domestic  
(Domestic Irrigation  
Municipal, Industrial, Other)

Description & Color of Materials Sand, Clay, Red Clay, Shell, etc.	Thick- ness Feet	Depth Feet
<u>Surface</u>	<u>8</u>	<u>8</u>
<u>Red Silt Clay</u>	<u>37</u>	<u>45</u>
<u>Blue Clay (Small pebbles)</u>	<u>100</u>	<u>145</u>
<u>Blue Clay</u>	<u>80</u>	<u>225</u>
<u>Silt Sand, Fair</u>	<u>37</u>	<u>262</u>
<u>Hard Blue Clay</u>	<u>50</u>	<u>312</u>
<u>Silt Sand, Good</u>	<u>14</u>	<u>326</u>
<u>Silt Sand, Fair</u>	<u>19</u>	<u>347</u>
<u>Grady Sand (Filler)</u>	<u>15</u>	<u>362</u>
<u>Hard Blue Clay</u>	<u>2</u>	<u>364</u>

Information upon completion of well:

(1) Diameter 2" inches.

(2) Total Depth 364' feet.

(3) Water Level 14' feet below top of ground.

(4) Cased to 350, Size 2"

(5) Screen: Size 2", Length 10'


(6) Were any formations sealed against pollution?  
yes, \_\_\_\_\_ no.

If YES depth of formation 10'

Why F.H.A. Pulling on Run.

Drillers Remarks: Good Sand  
at 225-262 wouldnt  
produce to good.

**CODED**

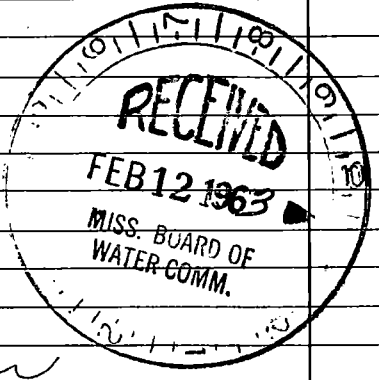

over

(Use Back Side)

Well No.

Shelf



Little Below River

1 1/2 miles

Well  
Bell Spring