

HAR.

MISSISSIPPI BOARD OF WATER COMMISSIONERS

G 51
10-63


WATER WELL DRILLERS LOG

CODED ↗

Date: Oct., 19 63, Driller: Joe Miller County: Harrison
(Name)

(1) Owner of Land	Description & Color of Materials Sand, Clay, Red Clay, Shell, etc.	Thick- ness Feet	Depth Feet
<u>Mr. Stewart</u> (Name) <u>RR# Sulfur Miss</u> (Address)	<u>Surface</u>	8	8
(2) Location: <u>SE 1/4, SE 1/4, Sec. 32 T. 15 R. 11 W.</u>	<u>Sand, Rd + Wh.</u>	7	15
<u>6</u> miles <u>North</u> , of <u>Sulfur</u> (distance) (direction) (Nearest Town)	<u>White Clay</u>	30	45
(3) Topography: <u>Hilly</u> (Hilly) (Flat) (Level)	<u>Red Clay & Sand</u>	34	79
(4) Purpose of Well: <u>Domestic</u> (Domestic Irrigation Municipal, Industrial, Other)	<u>Wh Clay - Brown Clay</u>	21	100
Information upon completion of well:	<u>Blue Gra. Clay</u>	4	106
(1) Diameter <u>2"</u> inches.	<u>Blue Gra Clay & Wood</u>	12	118
(2) Total Depth <u>517</u> feet.	<u>Blue Clay</u>	279	397
(3) Water Level <u>36'</u> feet below top of ground.	<u>Sand, (Fair)</u>	13	410
(4) Cased to <u>500</u> , Size <u>2"</u>	<u>Sand + Clay (Mainly)</u>	32	442
(5) Screen: Size <u>2"</u> , Length <u>10'</u>	<u>Gra Sand, (Fair)</u>	21	463
(6) Were any formations sealed against pollution? _____ yes, _____ no.	<u>Gra Sand, (Fair)</u>	10	473
If YES depth of formation _____	<u>Gra Sand, (Wood)</u>	37	510
Why _____	<u>Gra Sand, (Fair)</u>		517
Drillers Remarks: _____	<u>used 7' 7/8" Pipe</u>		

CODED

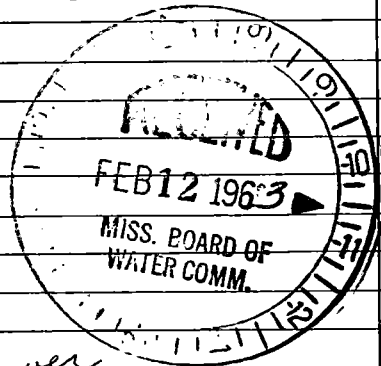

over

(Use Back Side)

Well No.

H/Ky 49

Wigent

John Clark Road.

• well