

HAR.
G52
10-9-63

MISSISSIPPI BOARD OF WATER COMMISSIONERS

CODED

WATER WELL DRILLERS LOG

CODED

Date: 10-9, 1963, Driller: Joe Miller County Harrison
Calvin location (Name)

(1) Owner of Land: Calvin Martin
(Name)
RPH Sufferd Mrs
(Address)
(2) Location: SW 1/4, SW 1/4, Sec. 32 T. 13R. 11W.
6 miles North, of Sufferd
(distance) (direction) (Nearest Town)
(3) Topography: Hilly
(Hilly) (Flat) (Level)
(4) Purpose of Well: Domestic
(Domestic Irrigation
Municipal, Industrial, Other)

Description & Color of Materials Sand, Clay, Red Clay, Shell, etc.	Thick- ness Feet	Depth Feet
Surface	✓	✓
Red Sandstone	4	8
Red + Red Clay	6	14
Red Sand (Fine)	60	74
Small Gravel (Brown)	14	88
Wk Clay (Small Sand)	162	190
Sand (Brown) (Fine)	27	217
Blue Clay	25	242
Gr Sand (Fine)	6	248
Gr Sand (Fine)	21	269
Gr Sand	21	290
Gr Sand (Coar)	42	332
" (Fine)	8	340
Clay Soft Wk	3	343

Information upon completion of well:

(1) Diameter 2" inches.
(2) Total Depth 569 feet.
(3) Water Level 43' feet below top of ground.
(4) Cased to 540, Size 2"
(5) Screen: Size 2", Length 10'
(6) Were any formations sealed against pollution?
✓ yes, no.


If YES depth of formation 7th ruling
Why on floor 10'

Drillers Remarks:

Used 1 1/2" Jail Pipe

CODED

CODED

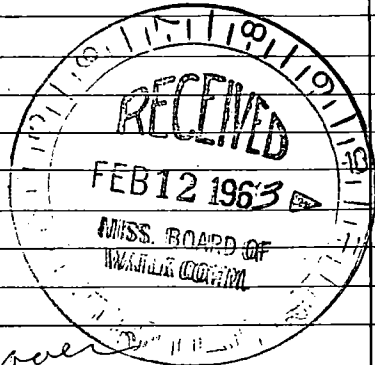

(Use Back Side)

Well No.

□ Guilford

65201

sk 49

Nugent

John Clark Rd.

Wed