

HAR.

MISSISSIPPI BOARD OF WATER COMMISSIONERS

G 54

1-30-64

WATER WELL DRILLERS LOG

Date Jan 30, 1964, Driller Joe Miller County Harrison

(1) Owner of Land: John Clark (Name) John Clark (Address) (2) Location: 1/4, 1/4, Sec. T R 6 miles North of Sulfur (distance) (direction) (Nearest town) (3) Topography: Flat (Hilly) (Flat) (Level) (4) Purpose of Well: Domestic (Domestic Irrigation Municipal, Industrial, Other)


Table with 3 columns: Description & Color of Materials, Thickness Feet, Depth Feet. Rows include: Surface (8, 8), Sand + Gravel (6, 14), Pink + Brown Clay (4, 18), White Clay (42, 60), Wh + Red Clay (10, 70), Red Sand (10, 80), Wh + Br. Clay (23, 103), Blue Clay (295, 398), Sand, NG Fine (12, 410), Sand, NG (14, 424), Sand, Clay, NG (52, 446), Sand, Fine (17, 463), Sand (32, 495), Lills. Balls (21, 516), Fines NS& (527, 527)

Information upon completion of well:

(1) Diameter 2 inches. (2) Total Depth 527 feet. (3) Water Level 37 feet below top of ground. (4) Cased to 506, Size 2 inches. (5) Screen: Size 2 inches, Length 10 feet. (6) Were any formations sealed against pollution? yes, no.

Used 10' Tail Pipe.

If YES depth of formation Why Drillers Remarks:

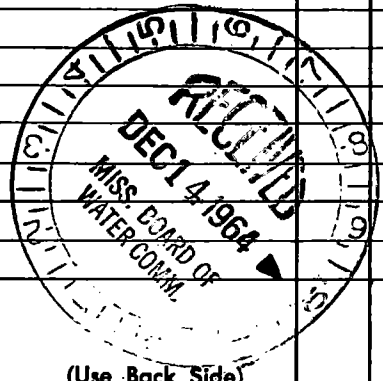

(Use Back Side)

Well No.

