

HAR.

G54

WATER WELL DRILLERS LOG

4-30-64

Date: Apr 30, 1964, Driller: Joe Miller County Harrison

(1) Owner of Land: Ferrulson
(2) Location: 1/4, 1/4, Sec. T R
(3) Topography: Flat
(4) Purpose of Well: Domestic


Table with 4 columns: Description & Color of Materials, Thickness Feet, Depth Feet. Rows include Surface, Wh Sand (Coarse), Iron Rock (Cap), Blue Gray Clay, Brown Clay, Br + Blu + Wh Clay, Brown Clay, Gray Sand, NG, No Clay, Blue Clay + Wood, Blue Clay, Sand, NG, Hard Blue Clay, Sand, NG, Fine, Hard Blue Clay, St Sand + Clay NG, Hard Blue Clay, St Sand, NG, Hard Blue Clay, Fine Gray Sand, Gray Sand (Fair), Sand, Hard Blue Clay.

Information upon completion of well:

(1) Diameter 2 inches.
(2) Total Depth 518 feet.
(3) Water Level 29 feet below top of ground.
(4) Cased to 504, Size 2
(5) Screen: Size 2, Length 10
(6) Were any formations sealed against pollution? yes, no.

If YES depth of formation
Why

Drillers Remarks:

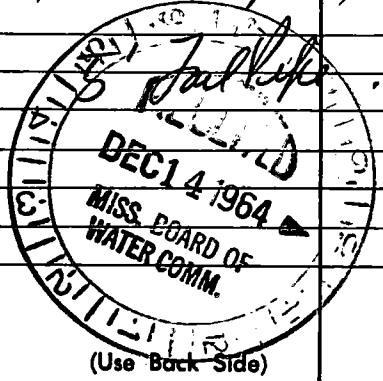

Well No.

Spk 53.

Lynman

Duckwalk Rd.

Spk River Rd.

← → 1 mile

1/2 R4 49

Shelby