

HAR.
G58
7-64

MISSISSIPPI BOARD OF WATER COMMISSIONERS

K393309

WATER WELL DRILLERS LOG

CODED

Date: July, 1964, Driller: Joe Miller County Harrison
(Name)

(1) Owner of Land: J. T. Lee
(Name)
Lezman Miss
(Address)

(2) Location: 1/4, 1/4, Sec. 29 T 6 R 11
4 miles East of Lezman
(distance) (direction) (Nearest Town)

(3) Topography: Flat
(Hilly) (Flat) (Level)

(4) Purpose of Well: Domestic
(Domestic Irrigation
Municipal, Industrial, Other)

Description & Color of Materials Sand, Clay, Red Clay, Shell, etc.	Thick- ness Feet	Depth Feet
<u>Surface</u>	<u>5</u>	<u>5</u>
<u>White Sand (Course)</u>	<u>41</u>	<u>46</u>
<u>Hard Blue Clay</u>	<u>86</u>	<u>232</u>
<u>Gray Sand, Fine</u>	<u>11</u>	<u>243</u>
<u>Sand Good</u>	<u>22</u>	<u>265</u>
<u>Hard Blue Clay</u>	<u>10</u>	<u>275</u>
<u>Hard Blue Clay</u>	<u>2</u>	<u>277</u>

Information upon completion of well:

(1) Diameter 2" inches.

(2) Total Depth 277 feet.

(3) Water Level Flowing feet below top of ground.

(4) Cased to 265, Size 2"

(5) Screen: Size 2", Length 10'


(6) Were any formations sealed against pollution?
_____ yes, _____ no.

If YES depth of formation _____

Why _____

Drillers Remarks: _____

CODED

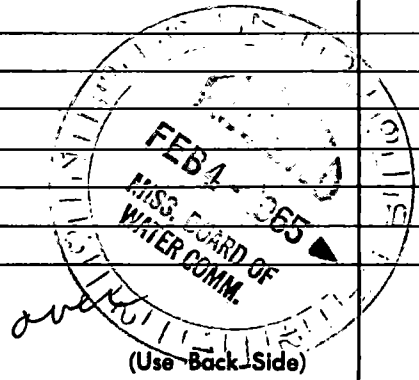

Well No.

(Use Back Side)

