

HAR.
G 59

WATER WELL DRILLERS LOG

Date: 11-18-64 1964, Driller: J. B. Bell County: Missouri

(Name)

(1) Owner of Land: Mrs W W Keeling
(Name)
John Clark RD Sulphur
(Address)

(2) Location: 8 miles n of Sulphur
(distance) (direction) (Nearest Town)

(3) Topography: X (Hilly) X (Flat) (Level)


(4) Purpose of Well: Home
(Domestic Irrigation
Municipal, Industrial, Other)

Description & Color of Materials Sand, Clay, Red Clay, Shell, etc.	Thick- ness Feet	Depth Feet
Red Clay	15	15
Fine sand	6	21
Soft white mud	63	89
Soft Blue mud	21	110
Hard Blue mud	42	150
White sand	84	236
Blue mud	21	257
Fine white sand	63	320
Hard Blue mud	85	405
Fine Blue sand	42	447
Hard Blue mud	29	476
Water sand	30	506

Information upon completion of well:

- (1) Diameter: 2" x 1 1/4" inches.
- (2) Total Depth: 506 feet.
- (3) Water Level: 49 feet below top of ground.
- (4) Cased to _____, Size _____.
- (5) Screen: Size 1/4", Length 15ft.
- (6) Were any formations sealed against pollution?
_____ yes, _____ no.

If YES depth of formation _____
Why _____
Drillers Remarks: _____

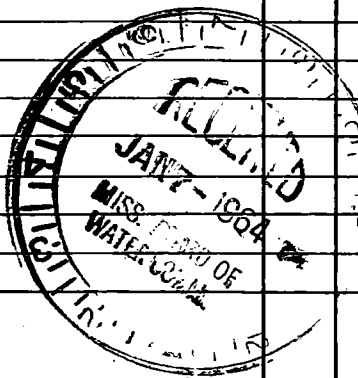

(Use Back Side)

Well No. _____

