

HAR.

MISSISSIPPI BOARD OF WATER COMMISSIONERS

G60

U326903

WATER WELL DRILLERS LOG

CODED

12-7-64

Date: Dec 7, 1964, Driller: Joe Miller County Harrison

(1) Owner of Land: Clarence Nettwith
 (Name)
R.R. Gulfport Miss
 (Address)

(2) Location: 1/4, 1/4, Sec. 19 to R11
10 miles West, of Gulfport
 (distance) (direction) (Nearest town)
to west of main

(3) Topography: Flat
 (Hilly) (Flat) (Level)

(4) Purpose of Well: Domestic
 (Domestic Irrigation
 Municipal, Industrial, Other)

Description & Color of Materials Sand, Clay, Red Clay, Shell, etc.	Thick- ness Feet	Depth Feet
<u>Br. Clay & Wk. Clay</u>	<u>10</u>	<u>40</u>
<u>Blue Clay</u>	<u>10</u>	<u>50</u>
<u>Fine sand, Fair</u>	<u>68</u>	<u>118</u>
<u>Clay & Wood</u>	<u>2</u>	<u>120</u>
<u>Blue Clay</u>	<u>42</u>	<u>162</u>
<u>Fine Blue Sand</u>	<u>15</u>	<u>177</u>
<u>Hard Blue Clay</u>	<u>225</u>	<u>402</u>
<u>Brk. Fine sand</u>		<u>411</u>
<u>Sand Gray Fair</u>	<u>21</u>	<u>432</u>
<u>" " Hard</u>	<u>2.5</u>	<u>457</u>
<u>" " N S G.</u>		<u>464</u>

Information upon completion of well:

(1) Diameter 2 inches.

(2) Total Depth 457' feet.


(3) Water Level: 34 feet below top of ground.

(4) Cased to 447, Size 2"

(5) Screen: Size 2", Length 10'

(6) Were any formations sealed against pollution?
 _____ yes, _____ no.

CODED

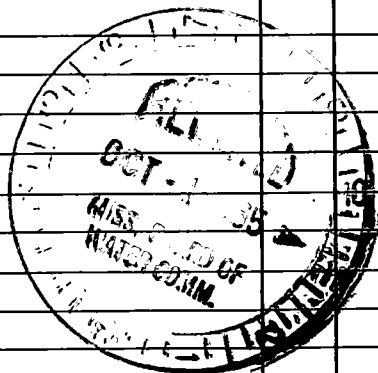

If YES depth of formation _____

Why _____

Drillers Remarks: Sand from
68-118 carried a
lot of Iron, or Flavis
Clayest Fixture


(Use Back Side)

Well No.

2000

S

HKY 49

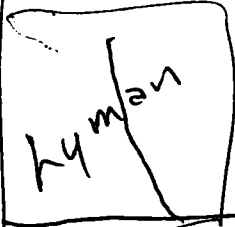

Rt 53

Clarence Street

W

N

E