

G61 ✓ 395512

1-65

WATER WELL DRILLERS LOG **CODED**

Date: Jan, 1965, Driller: Joe Miller County Harrison
 (Name)

(1) Owner of Land: E. J. Entzine
 (Name)
P.O. Lyman
 (Address)

(2) Location: 1/4, 1/4, Sec. 36 T6 R11
 _____ miles _____ of _____
 (distance) (direction) (Nearest Town)

(3) Topography: Hilly
 (Hilly) (Flat) (Level)

(4) Purpose of Well: Domestic
 (Domestic Irrigation
 Municipal, Industrial, Other)

Information upon completion of well:

(1) Diameter 2 inches.

(2) Total Depth 470 feet.

(3) Water Level 39' feet below top of ground.

(4) Cased to 460, Size 2"


(5) Screen: Size 2", Length 10'

(6) Were any formations sealed against pollution?
 _____ yes, _____ no.

If YES depth of formation _____
 Why _____

Drillers Remarks: _____

Description & Color of Materials Sand, Clay, Red Clay, Shell, etc.	Thick- ness Feet	Depth Feet
Surface	5	5
Red Clay Red sand	73	78
White Clay	34	122
Clay sand	5	127
Blue Clay	53	180
Hard Blue Clay	58	238
Small Bd.	3	241
Blue Clay	34	275
Softer	10	285
Fine grey sand	5	290
" " " " <u>to bottom</u>	5	295
Hard Blue Clay	100	395
Grey sand (Frick)	6	401
" " " " Fair	10	411
" " " " "	10	421
" " " " Lull Beak	11	432
" " " " Good	10	442
" " " " "	11	453
" " " " "	11	464
" " " " "	6	470

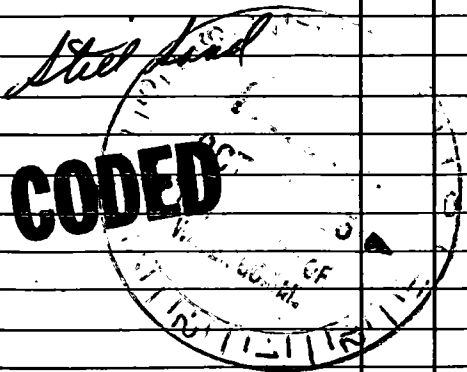

(Use Back Side)

Well No.

1000

S

49 Acres

W

S Swan Rd

Lyman

N

