

G 62
5-6-65

WATER WELL DRILLERS LOG

Date: May 6, 1965, Driller: Joe Miller County Harrison
(Name)

(1) Owner of Land Wm Watkins
(Name)
Gulfport Miss
(Address)

(2) Location: 1/4, 1/4, Sec. T R
10 miles North of Gulfport
(distance) (direction) (Nearest Town)

(3) Topography: Hilly
(Hilly) (Flat) (Level)

(4) Purpose of Well: Domestic
(Domestic Irrigation
Municipal, Industrial, Other)

Description & Color of Materials Sand, Clay, Red Clay, Shell, etc.	Thick- ness Feet	Depth Feet
Red Cl, Wh Cl Mix	27	27
Blue Clay	13	40
Clay + Wood	10	50
Blue Clay (Hard)	15	65
Hard Blue Clay	17	82
Gr Sand (Fair)	17	99
Hard Blue Clay	52	151
Gray Sand Fine	7	158
Hard Blue Clay	97	255
Gray Sand (Fair)	21	276
" " (Fair)	10	286
" " (Good)	53	339

Information upon completion of well:

(1) Diameter 2" inches.

(2) Total Depth 475' feet.


(3) Water Level 36' feet below top of ground.

(4) Cased to 460, Size 2"

(5) Screen: Size 2", Length 10'

(6) Were any formations sealed against pollution?
 yes, no.

5' Tail Pipe

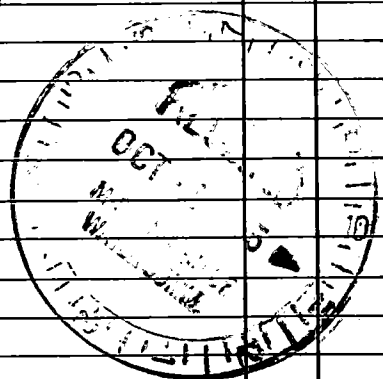

If YES depth of formation _____
Why _____
Drillers Remarks: _____

(Use Back Side)

Well No.

HKy 49 S

Lyman

53 HKy

KW Ranch

E

W

N

