

G64 K394708

7-22-65

WATER WELL DRILLERS LOG

CODED

Date: July 22, 1965, Driller: Joe Miller County Harrison

(Name)

(1) Owner of Land: Vincent Purser
(Name)
Duckworth Rd. Gulfport
(Address)

(2) Location: 33 6 11
T R
8 miles N of Gulfport
(distance) (direction) (Nearest Town)

(3) Topography: Hilly
(Hilly) (Flat) (Level)

(4) Purpose of Well: Domestic
(Domestic Irrigation
Municipal, Industrial, Other)

Description & Color of Materials Sand, Clay, Red Clay, Shell, etc.	Thick- ness Feet	Depth Feet
Surface	5	5
Red Clay Red Sd	59	64
White Clay	7	71
Blue "	14	185
Grey Sd. Fine	33	218
Blue Clay	13	231
Grey Sand (Fair)	21	252
Hard Blue Clay	79	331
Grey Sand (Fair)	17	348
" " (Good)	30	378
" " "	7	385

Information upon completion of well:

(1) Diameter 2" inches.

(2) Total Depth 385 feet.

(3) Water Level 44' feet below top of ground.

(4) Cased to 370', Size 2"

(5) Screen: Size 2", Length 10'

(6) Were any formations sealed against pollution?
_____ yes, _____ no.


If YES depth of formation _____

Why _____

Drillers Remarks: _____

5 Tail Pipe

CODED

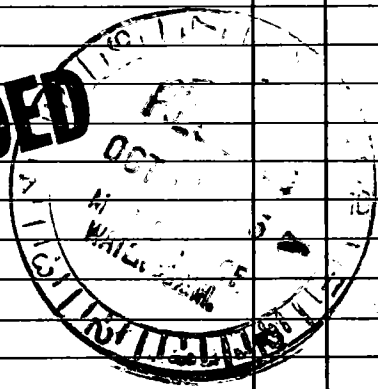

(Use Back Side)

Well No.

113399

HKy 49

Vincent
Borser

Duckworth Rd.

E

W

Lymem

53 HKy

N