

HAR,  
G 65

MISSISSIPPI BOARD OF WATER COMMISSIONERS

8-14-65

WATER WELL DRILLERS LOG

Date: Aug 14, 1965; Driller: Joe Miller County Harrison

(Name)

(1) Owner of Land: Russell Lott  
(Name)  
3024 Gulfport Miss  
(Address)

(2) Location: 1/4, 1/4, Sec.     T     R      
10' miles North of Gulfport  
(distance) (direction) (Nearest Town)

(3) Topography: Hilly  
(Hilly) (Flat) (Level)

(4) Purpose of Well: Domestic  
(Domestic Irrigation  
Municipal, Industrial, Other)

| Description & Color of Materials<br>Sand, Clay, Red Clay, Shell, etc. | Thick-<br>ness<br>Feet | Depth<br>Feet |
|---|------------------------|---------------|
| Surface   | 8                      | 8             |
| Red Clay Red sd   | 23                     | 31            |
| White Clay  | 59                     | 90            |
| Blue Clay   | 144                    | 234           |
| Gray Sand (Fine)  | 11                     | 245           |
| Hard Blue Clay  | 135                    | 380           |
| Gray Sand (Fine)  | 10                     | 390           |
| " " (Fair)  | 32                     | 422           |
| " " Good  | 35                     | 457           |
| Still Sand.   |                        |               |

Information upon completion of well:

(1) Diameter 2" inches.

(2) Total Depth 457 feet.


(3) Water Level 46.5 feet below top of ground.

(4) Cased to 442, Size 2"

(5) Screen: Size 2", Length 10'

(6) Were any formations sealed against pollution?  
\_\_\_\_\_ yes, \_\_\_\_\_ no.

5' Fair Pipe

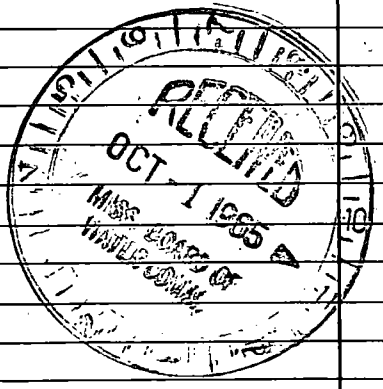

If YES depth of formation \_\_\_\_\_

Why \_\_\_\_\_

Drillers Remarks: \_\_\_\_\_

(Use Back Side)

Well No.

H Ky 49

Lyman Miss

Swan Rd

H Ky 53

Adlan Rd.

Russell  
Latt

