

G-66
9-1-64

WATER WELL DRILLERS LOG

CODED

Date: 9-1-64, 19___, Driller: C. T. SWITZER WELL CO. County: Harrison
(Name)

(1) Owner of Land: Louis King
(Name)

Duckworth Road Gulfport
(Address)

(2) Location: ___ 1/4, ___ 1/4, Sec. 34 T. R S. 6 11
miles (distance), of (direction), of (Nearest Town)

(3) Topography: X
(Hilly) (Flat) (Level)

(4) Purpose of Well: Domestic
(Domestic Irrigation, Municipal, Industrial, Other)

Description & Color of Materials Sand, Clay, Red Clay, Shell, etc.	Thick- ness Feet	Depth Feet
Clay + sand	0	24
Sand + gravel	24	44
Sand streaks	44	65
Clay	65	108
Clay + sand streaks	108	131
Sand	131	146
Clay	146	153
Clay + sand streaks	153	175
Clay	175	196
Clay + sand streaks	196	218
Clay	218	229
Sand	229	239
Sand good	239	251
Clay	251	269
Sand fine	269	282
Clay	282	334
Sand	334	342
Clay	342	346
Sand fair	346	368
Sand	368	374
Sand streaks	374	389
Clay	389	411
Sand good	411	478

Information upon completion of well:

(1) Diameter 2" inches.

(2) Total Depth 478 feet.

(3) Water Level 28- feet below top of ground.

(4) Cased to 478, Size 2"


(5) Screen: Size 8ga, Length 15'

(6) Were any formations sealed against pollution?
X yes, ___ no.

If YES depth of formation _____

Why Health Dept. Requirements

Drillers Remarks: _____

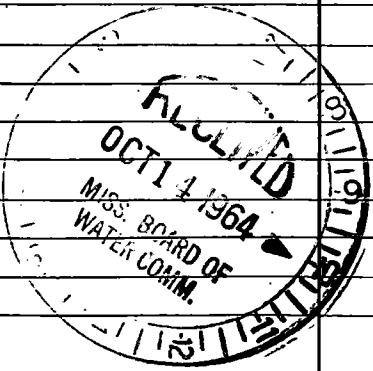

(Use Back Side)

Well No.

1000

1000

[Faint, mostly illegible text, possibly a list or ledger with columns and rows. Some words like "Name", "Address", "City", "State", "Zip" are faintly visible.]

1111

1111