

CODED

WATER WELL DRILLERS LOG

Date: Mar 12, 1966, Driller: Joe Miller County Harrison
(Name)

(1) Owner of Land: Hugh Stewart
(Name)
 RR # Selfport
(Address)
 (2) Location: 1/4, 1/4, Sec. 28 T. 5 R. W, 6 11
1 miles East of Lyman
(distance) (direction) (Nearest Town)
 (3) Topography: Hilly
(Hilly) (Flat) (Level)
 (4) Purpose of Well: Domestic
(Domestic Irrigation Municipal, Industrial, Other)

Description & Color of Materials Sand, Clay, Red Clay, Shell, etc.	Thick- ness Feet	Depth Feet
Surface	5	5
Wh Sand + Red sand	17	22
Red + Wh Clay	9	31
Blue Clay	12	43
Blue Clay Wh Clay	74	117
Am Bl. Blue sand, Wh	13	130
Hard Blue Clay	108	238
Soft	10	248
Hard Blue Clay	254	274
Heavy sand, Fine	8	285
Soft	11	296
Hard Blue Clay	5	301


Information upon completion of well:

(1) Diameter 2 inches.
 (2) Total Depth 301 feet.
 (3) Water Level 43' feet below top of ground.
 (4) Cased to 286', Size 2"
 (5) Screen: Size 2", Length 10'
 (6) Were any formations sealed against pollution?
 _____ yes, _____ no.

If YES depth of formation _____
 Why _____
 Drillers Remarks: _____

CODED

5' Fuel Pipe

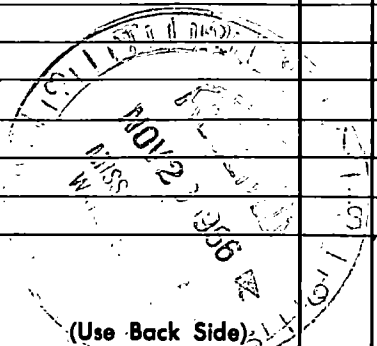

(Use Back Side)

Well No.

N

HRy
53

Leyman

Stein
Well

~~Dickworth Rd.~~
South Swan Rd.

E

W

S