

Harrison
G73
5-66

WATER WELL DRILLERS LOG

CODED

Date: May 6, 1966, Driller: Joe Miller County Harrison
(Name)

(1) Owner of Land: Ryman Lion Club
(Name)
RR # Bullback
(Address)

(2) Location: NE 1/4, NE 1/4, Sec. 29 T65R11W
1/2 miles W of Loman
(distance) (direction) (Nearest Town)

(3) Topography: Hilly
(Hilly) (Flat) (Level)

(4) Purpose of Well: Domestic
(Domestic Irrigation
Municipal, Industrial, Other)

Description & Color of Materials Sand, Clay, Red Clay, Shell, etc.	Thick- ness Feet	Depth Feet
<u>Br + W. Clay. Med</u>	<u>25</u>	<u>25</u>
<u>Blue Clay</u>	<u>91</u>	<u>116</u>
<u>Grey sand (fine)</u>	<u>10</u>	<u>126</u>
<u>Hard Blue Clay</u>	<u>201</u>	<u>327</u>
<u>Hard Blue Clay</u>	<u>63</u>	<u>390</u>
<u>Shummy Hard</u>	<u>9</u>	<u>401</u>
<u>Softer</u>	<u>5</u>	<u>406</u>
<u>Brk. sand. Fine</u>	<u>5</u>	<u>411</u>
<u>Sand, Gray (Fair)</u>	<u>11</u>	<u>422</u>
<u>" " Good</u>	<u>10</u>	<u>432</u>
<u>" " "</u>	<u>11</u>	<u>443</u>
<u>" " Little fines</u>	<u>11</u>	<u>454</u>

Information upon completion of well:

(1) Diameter 2 inches.

(2) Total Depth 454' feet.

(3) Water Level 45' feet below top of ground.

(4) Cased to 440, Size 2"


(5) Screen: Size 2", Length 10'

(6) Were any formations sealed against pollution?
X yes, no.

If YES depth of formation 10' Down
Why from surface

Drillers Remarks:

CODED

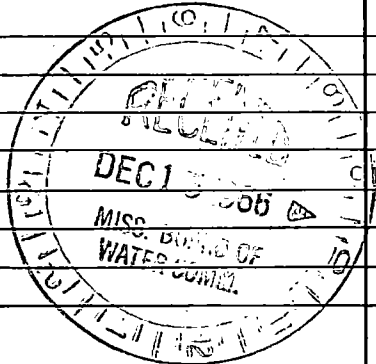

(Use Back Side)

Well No.

1960