

Harrison
G 74
5-66

MISSISSIPPI BOARD OF WATER COMMISSIONERS

CODED WATER WELL DRILLERS LOG

CODED

Date: May 2, 1966, Driller: Joe Miller County Harrison
Elmer Callahan (Name)

(1) Owner of Land: Elmer Callahan
(Name)
RR# Shelbourn Miss
(Address)
(2) Location: 1/4, 1/4, Sec. 28 T. 5. R. 11
1 miles E of Lyman
(distance) (direction) (Nearest Town)
(3) Topography: Hilly
(Hilly) (Flat) (Level)
(4) Purpose of Well: Domestic
(Domestic Irrigation
Municipal, Industrial, Other)

Description & Color of Materials Sand, Clay, Red Clay, Shell, etc.	Thick- ness Feet	Depth Feet
<u>Hard Clay, Whit Br.</u>	<u>9</u>	<u>9</u>
<u>Red Sand.</u>	<u>16</u>	<u>25</u>
<u>Red Clay, Red Clay.</u>	<u>13</u>	<u>38</u>
<u>White Clay.</u>	<u>80</u>	<u>118</u>
<u>Gray sand.</u>	<u>23</u>	<u>141</u>
<u>Hard Blue Clay.</u>	<u>94</u>	<u>235</u>
<u>Gray sand.</u>	<u>6</u>	<u>241</u>
<u>Blue Clay, Iron Pe.</u>	<u>139</u>	<u>380</u>
<u>Sand, Blue, Fine</u>	<u>18</u>	<u>398</u>
<u>Hard Blue Clay.</u>	<u>5</u>	<u>398</u>
<u>Gray Sand - Fine</u>	<u>24</u>	<u>422</u>
<u>" " Hood</u>	<u>32</u>	<u>454</u>

Information upon completion of well:


(1) Diameter 2" inches.
(2) Total Depth 454' feet.
(3) Water Level 46' feet below top of ground.
(4) Cased to 440', Size 2"
(5) Screen: Size 2", Length 10'
(6) Were any formations sealed against pollution?
_____ yes, _____ no.

CODED

Still sand!

CODED

If YES depth of formation _____
Why _____
Drillers Remarks: _____

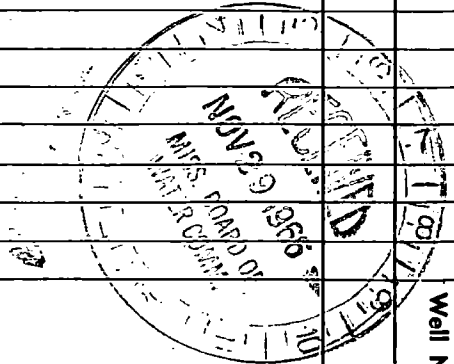

(Use Back Side)

Well No.

2000

2000

N

S

HRy 53

freeway

A Swan Road

Callahan Well.

G 74

HRy 49

a

E

