

Harrison
G 76
6-66

MISSISSIPPI BOARD OF WATER COMMISSIONERS

WATER WELL DRILLERS LOG

CODED

Date: June 1, 1966, Driller: Joe Miller County Harrison
(Name)

(1) Owner of Land Mike Smith
(Name)

P.O. Box Lyman
(Address)

(2) Location: NE 1/4, NE 1/4, Sec. 29 T65R11W
_____ miles _____ of _____
(distance) (direction) (Nearest Town)

(3) Topography: Hilly
(Hilly) (Flat) (Level)

(4) Purpose of Well: Domestic
(Domestic Irrigation
Municipal, Industrial, Other)

| Description & Color of Materials Sand, Clay, Red Clay, Shell, etc. | Thick- ness Feet | Depth Feet |
|---|------------------------|---------------|
| Brown Clay | 10 | 10 |
| Wh + Br Clay | 30 | 40 |
| Blue Clay | 66 | 106 |
| Gray sand | 26 | 132 |
| Blue Clay | 53 | 185 |
| Gray sd. (fine) | 10 | 195 |
| Hard Blue Clay | 45 | 240 |
| Sand, N.C. fine | 11 | 251 |
| Hard Blue Clay | 34 | 285 |
| Small Brakes + Clay | 45 | 330 |
| Gray sand - (fine) | 7 | 337 |
| " " (fine) | 11 | 348 |
| Hard Blue Clay | 68 | 416 |
| Gray sand, fine | 6 | 422 |
| " " sand | 11 | 433 |
| " " " | 11 | 444 |
| " " " | 11 | 454 |
| " " (fine) | 5 | 459 |

Information upon completion of well:

(1) Diameter 2' inches.

(2) Total Depth 459 feet.

(3) Water Level 43' feet below top of ground.

(4) Cased to 444, Size 2"


(5) Screen: Size 2", Length 10'

(6) Were any formations sealed against pollution?
_____ yes, _____ no.

If YES depth of formation _____

Why _____

Drillers Remarks: _____

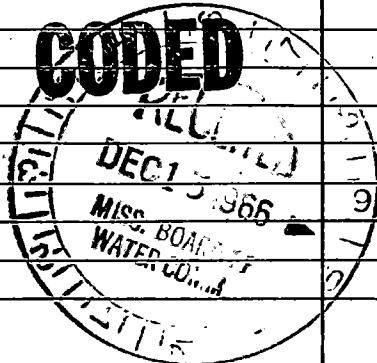

(Use Back Side)

Well No.

100

•