

G 77
6-66

WATER WELL DRILLERS LOG

CODED

Date: June 21, 1966, Driller: Joe Miller County: Harrison
(Name)

(1) Owner of Land: Mr. P. P. P. P.
(Name)
RR # Gulfport Miss
(Address)

(2) Location: SE 1/4, NE 1/4, Sec. 34 T6SR11W
3 miles East of Lynon,
(distance) (direction) (Nearest Town)

(3) Topography: Hilly
(Hilly) (Flat) (Level)

(4) Purpose of Well: Domestic
(Domestic Irrigation
Municipal, Industrial, Other)

Description & Color of Materials Sand, Clay, Red Clay, Shell, etc.	Thick- ness Feet	Depth Feet
Surface (Sandy)	8	8
Red + Br Clay	3	11
Red Clay	11	22
Wh Clay	5	27
Blue Clay + Wood	5	32
White Clay	28	60
Red of white Cl. Br Cl.	11	71
White Clay	25	96
Hard Blue Clay	142	238
Hard Blue Clay Sm. Br.	175	413
Silt	8	421
Gray sand, Fine	11	432
" " "	21	453
Hard Clay	5	458
Sand Gray Good	6	464
" " "	10	474
" " "	11	485
" " <u>Red</u>	5	490
<u>5' Iron pipe</u>		

Information upon completion of well:

(1) Diameter 2" inches.

(2) Total Depth 490' feet.

(3) Water Level 17' feet below top of ground.

(4) Cased to 475', Size 2"

(5) Screen: Size 2", Length 10'


(6) Were any formations sealed against pollution?
_____ yes, _____ no.

If YES depth of formation _____

Why _____

Drillers Remarks: _____

CODED

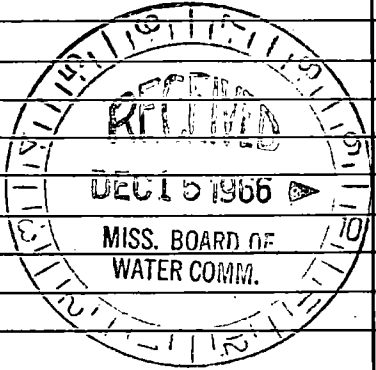

(Use Back Side)

Well No.

1933