

Harrison  
G 80  
8-66

MISSISSIPPI  
 BOARD OF WATER COMMISSIONERS  
 416 North State Street  
 Jackson, Mississippi 39201

**CODED**

WATER WELL DRILLERS LOG

Aug. 23 1966 M&B Drilling Co. Harrison  
 date well completed firm name county well located

LANDOWNER: Larry Williams  
Three Rivers Rd. P.O.  
Gulfport, Miss.  
 (mailing address)

description of formations encountered	from	to
Surface	0	10
White Clay	10	20
White Sand	20	30
Red Clay	30	80
Blue Clay	80	150
Grey Sand	150	200
Blue Clay	200	+

WELL LOCATION:  
 sec 34 T. 6 R. 11  
5 1/2 miles N of Gulfport  
 (distance) (direction) (nearest town)


WELL PURPOSE: Home  
 (home, irrigation, municipal, industrial)

WELL COMPLETION DATA:

- (1) diameter (inches) 2"
- (2) total depth (feet) 200
- (3) static water level (feet) 31 below top of ground.
- (4) casing Galv. Steel 190  
 (material) (depth)  
2" If telescope see back.  
 (size)
- (5) screen 10ft, 190  
 (length) (depth to top)
- (6) pump 1/2 10  
 (HP) (field gpm)  
110V 1Ø  
 (type power)
- (7) electric log No  
 (yes or no)  
 (organization running log)
- (8) how well bottom plugged 2"  
Back Wash Valve

State has run  
electric log about 100ft  
East of this hole for  
us. below on another well  
of same depth  
free. Broken.

**CODED**

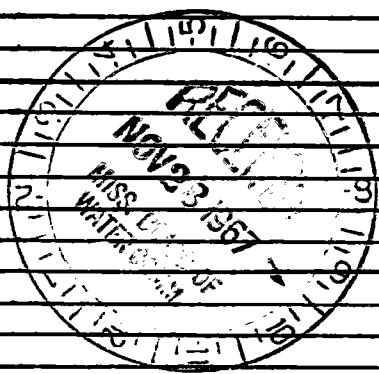


DRILLERS REMARKS:

If well telescopes please sketch and show depths.

GROUND LEVEL

bottom of first screen

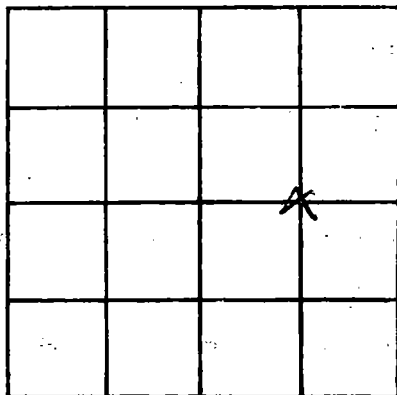

SECTION 34

Please indicate well location X.

ADDITIONAL INFORMATION

If more than one screen, show locations of each on sketch.