

Harrison
 G82
 9-66

MISSISSIPPI BOARD OF WATER COMMISSIONERS

WATER WELL DRILLERS LOG **CODED**

Date: 9-9, 1966, Driller: Inter Well Works County Harrison
 (When well drilled) (Name) (Where well is located)

(1) Owner of Land: JAMES TRAVIRCA
 (Name)
Bay St. Louis, Miss.
 (Address)

(2) Location: SW 1/4, NE 1/4, Sec. 36 T65N14W
4 miles N of Gulfport
 (distance) (direction) (Nearest Town)

(3) Topography: Level
 (Hilly) (Flat) (Level)

(4) Purpose of Well: domestic
 (Domestic Irrigation
 Municipal, Industrial, Other)

Description & Color of Materials Sand, Clay, Red Clay, Shell, etc.	Thick- ness Feet	Depth Feet
Clay	18	18
sand	20	38
Clay	212	250
sand	24	274
clay	196	470

Information upon completion of well:

(1) Diameter 2 inches.

(2) Total Depth 274 feet.

(3) Water Level 35 feet below top of ground.

(4) Cased to all, Size 2"

(5) Screen: Size 2", Length 10'

(6) Were any formations sealed against pollution?
 yes, no.

CODED

If YES depth of formation _____

Why _____

Drillers Remarks: _____

Yield in gpm: 15

Size pump: 1HP

Type power: ELEC.

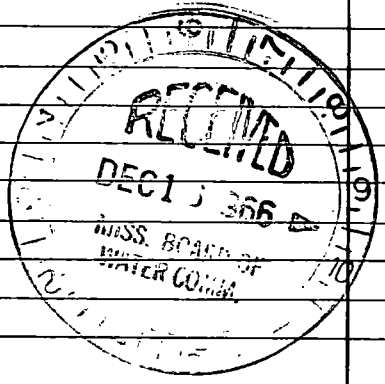


Table with 2 columns and multiple rows, mostly blank.

Faint handwritten notes and scribbles, possibly bleed-through from the reverse side of the page.