

Harrison
 G 85
 4-67

MISSISSIPPI
 BOARD OF WATER COMMISSIONERS
 416 North State Street
 Jackson, Mississippi 39201

CODED

WATER WELL DRILLERS LOG

April 12 1967 M&B Drilling Co. Harrison
 date well completed firm name county well located

LANDOWNER: W. T. Wilson
P.O. Box 2508
Gulfport, Miss.
 (mailing address)

WELL LOCATION:
 sec. 27 T. 6 S. R. 11 W.
 _____ miles _____ of Lyman
 (distance) (direction) (nearest town)

WELL PURPOSE: Home
 (home, irrigation, municipal, industrial)

WELL COMPLETION DATA:
 (1) diameter (inches) 2"
 (2) total depth (feet) 438
 (3) static water level (feet) 32 below above
 top of ground.
 (4) casing PVC Plastic 429
 (material) (depth)

_____ If telescope see back.
 (size)
 (5) screen 9 FT 429
 (length) (depth to top)
2" PVC Filter Pac rounded
 (size) (material) sand

(6) pump 1 15
 (HP) (yield gpm)
110 Volt 1φ
 (type power)

(7) electric log No
 (yes or no)


_____ (organization running log)

(8) how well bottom plugged 2" Cap

description of fomations encountered	from	to
Brown & White Clay	0	15
White Clay	15	23
Blue Clay	23	35
Sand & Clay Breaks	35	50
Blue Clay	50	75
Sand & Clay Breaks	75	95
Blue Clay	95	115
Sand & Clay Breaks	115	165
Blue Clay	165	180
Sand & Clay Breaks	180	200
Blue Clay	200	249
Sand	249	253
Blue Clay	253	276
Medium Grey Sand	276	286
Blue Clay	286	400
Sand	400	438+

Bottomed in Pool Sand

CODED

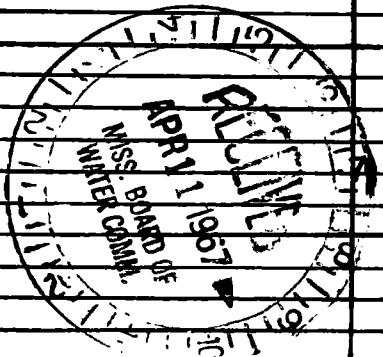

DRILLERS REMARKS:
Circulation loss 360-390
and blue shale & clay

