

Harrison
G 86
5-67

MISSISSIPPI
BOARD OF WATER COMMISSIONERS
416 North State Street
Jackson, Mississippi 39201

CODED

WATER WELL DRILLERS LOG

May 17 1967 M & B Drilling Co. Harrison
date well completed firm name county well located

LANDOWNER: Hollis Holston
Old Hwy 49
Lynn, Miss.
(mailing address)

WELL LOCATION:
sec. 29 T. 6 N. R. 11 E. S. 5 W.
_____ miles _____ of Lynn
(distance) (direction) (nearest town)

WELL PURPOSE: Home
(home, irrigation, municipal, industrial)

WELL COMPLETION DATA:

(1) diameter (inches) 2

(2) total depth (feet) 460

(3) static water level (feet) 57 below ~~above~~ top of ground.

(4) casing PVC 450
(material) (depth)
2"
(size) If telescope see back.


(5) screen 10 450
(length) (depth to top)
2" PVC Sand Filterpac
(size) (material)

(6) pump 1/2 8
(HP) (yield gpm)
110
(type power)

(7) electric log No
(yes or no)
(organization running log)

(8) how well bottom plugged
PVC Cap

description of formations encountered	from	to
Surface	0	7
White Clay	7	10
Multi-colored clay	10	15
White Clay	15	18
Light Blue Clay	18	50
Sandy Grey Clay Breaks	50	70
Sand	70	82
Sand & Clay Breaks	82	132
Blue Clay	132	144
Sand	144	150
Grey Clay	150	187
Blue Clay	187	327
Fine Sand	327	332
Blue Clay	332	365
Sand	365	377
Blue Clay	377	425
Sand	425	460
Still Cutting Sand		
When Drilling Stopped		

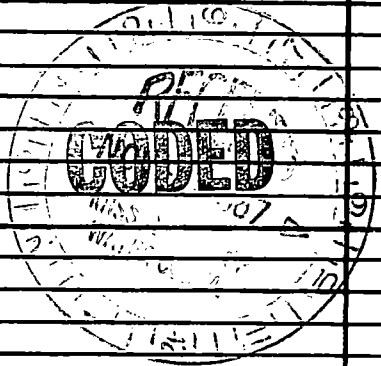

DRILLERS REMARKS:

If well telescopes please sketch and show depths.

GROUND LEVEL

Horizontal flow etc.

	X		

SECTION 29

Please indicate well location X.

ADDITIONAL INFORMATION

If more than one screen, show locations of each on sketch.