

HARRISON  
G 89  
7-67

MISSISSIPPI  
BOARD OF WATER COMMISSIONERS  
416 North State Street  
Jackson, Mississippi 39201

**CODED**

WATER WELL DRILLERS LOG

July 12 1967 R. J. Moore Harrison County  
date well completed firm name county well located

LANDOWNER: Herman Avey  
RR#1, Box 164D  
Culport Miss.  
(mailing address)

description of formations encountered	from	to
Top soil	0	10
Red Clay	10	40
White Clay	40	51
Blue Clay	51	79
Blue Sand	79	83
Blue Clay	83	104
Blue Sand	104	125


WELL LOCATION:  
sec. 26 T. 6 N. R. 11 E.  
8 miles North of Culport  
(distance) (direction) (nearest town)

WELL PURPOSE: Home  
(home, irrigation, municipal, industrial)

WELL COMPLETION DATA:

- (1) diameter (inches) 2"
- (2) total depth (feet) 125 ft
- (3) static water level (feet) 20 <sup>below</sup> top of ground.
- (4) casing 2" galv. (material), 119 ft. (depth)
- (5) screen 5' (length), 120 ft. (depth to top)  
2" #8, Bronz (size) (material)
- (6) pump (HP) (yield gpm)  
(type power)
- (7) electric log NO (yes or no)  
(organization running log)
- (8) how well bottom plugged back  
wash valve

**CODED**

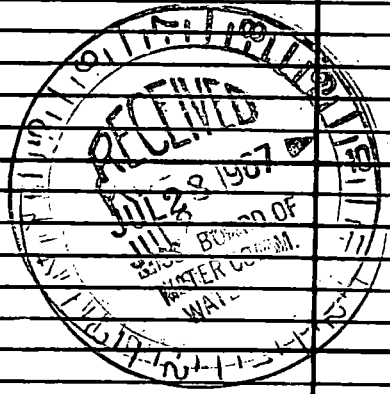

DRILLERS REMARKS:

If well telescopes please sketch and show depths.

GROUND LEVEL

	X		

SECTION 26

Please indicate well location X.

ADDITIONAL INFORMATION

If more than one screen, show locations of each on sketch.