

HARRISON
G 90
7-67

MISSISSIPPI
BOARD OF WATER COMMISSIONERS
416 North State Street
Jackson, Mississippi 39201

CODED

WATER WELL DRILLERS LOG

July 12, 1967 19 R. J. Moore Harrison County
date well completed firm name county well located

LANDOWNER: L. F. Paster, Jr.
P.O. Box 74
Culport, Miss.
(mailing address)

description of formations encountered	from	to
Top Soil	0	10
Red & Blue Clay	10	80
White Sand	80	90
Clay balls	90	120
Silty Sand	120	125
Blue Clay	125	160
Rusty Sand	160	170
Blue Clay	170	284
Blue Sand (Med)	284	314

WELL LOCATION:
sec. 19 T 6 N R 11 E
12 miles North of Culport
(distance) (direction) (nearest town)

WELL PURPOSE: home
(home, irrigation, municipal, industrial)

WELL COMPLETION DATA:

(1) diameter (inches) 2"

(2) total depth (feet) 314 ft

(3) static water level (feet) 42' below top of ground.

(4) casing 2" galv. 304 ft
(material) (depth)

(size) if telescope see back.

(5) screen 10' 304 ft
(length) (depth to top)

2" #8 Stainless Steel
(size) (material)

(6) pump 1 hp 5 gal
(HP) (yield gpm)


electric
(type power)

(7) electric log NO
(yes or no)

(organization running log)

(8) how well bottom plugged back
wash valve

CODED

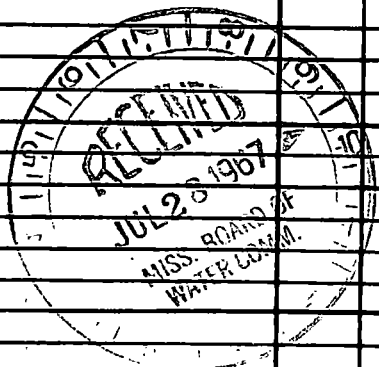

DRILLERS REMARKS:

