

Harrison
G 91
8-67

MISSISSIPPI
BOARD OF WATER COMMISSIONERS
416 North State Street
Jackson, Mississippi 39201

CODED

WATER WELL DRILLERS LOG

8-7-69 1967 Hattiesburg Butane HARRISON
date well completed firm name county well located

LANDOWNER: B.C. Kelly
Route 3 Box 325
Grenada, Miss.
(mailing address)

description of formations encountered	from	to
yellow sand	0	5
yellow clay	6	9
white clay	10	11
white sand	12	19
white clay	20	97
white & blue sand	98	189
Blue Clay & blue sand	190	230
Blue sand	231	242


WELL LOCATION:
sec. 35 T. 6 S. R. 11 W.
3 miles EAST of NUGENT
(distance) (direction) (nearest town)

WELL PURPOSE: Home
(home, irrigation, municipal, industrial)

WELL COMPLETION DATA:

(1) diameter (inches) 2"
(2) total depth (feet) 242'
(3) static water level (feet) 30' below top of ground.
(4) casing GALV. pipe 232' (material) (depth)
2" (size) If telescope see back.
(5) screen 10' (length) 232' (depth to top)
2" (size) BRONZE (material)
(6) pump 1 (HP) 500 (yield gpm)
ELECTRIC (type power)
(7) electric log NO (yes or no)
NO (organization running log)
(8) how well bottom plugged BACK WASH VALVE


CODED

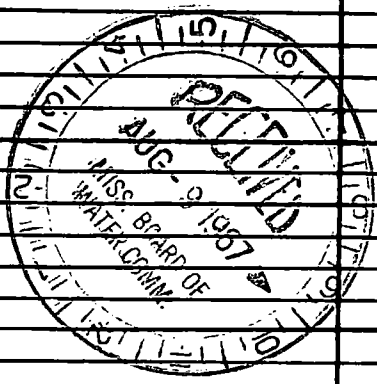

DRILLERS REMARKS:

If well telescopes please sketch and show depths.

GROUND LEVEL

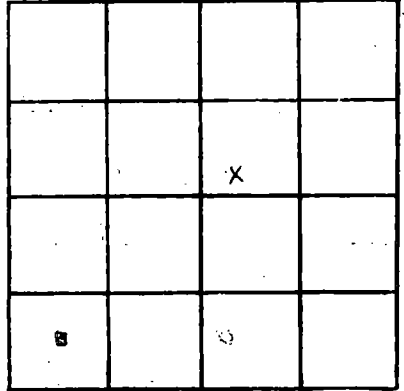

SECTION 35

Please indicate well location X.

ADDITIONAL INFORMATION

*1/2 mile North of Thompson
Road, 3 miles East
of Wagent.*

If more than one screen,
show locations of each on sketch.