

Harrison
G 92
9-67

MISSISSIPPI
BOARD OF WATER COMMISSIONERS
416 North State Street
Jackson, Mississippi 39201

WATER WELL DRILLERS LOG

CODED

Sept. 26 1967 R. J. Moore
date well completed firm name county well located

LANDOWNER: J. D. ROBINSON
RT 1 Box 170
GULFPORT, MISS
(mailing address)

WELL LOCATION:
sec 26 T 6 N R 11 E
12 miles NORTH of GULFPORT
(distance) (direction) (nearest town)

WELL PURPOSE: HOME
(home, irrigation, municipal, industrial)

WELL COMPLETION DATA:

- (1) diameter (inches) 2"
- (2) total depth (feet) 493'
- (3) static water level (feet) 42' ^{below} top of ground
- (4) casing 2" galv. 493'
(material) (depth)
- (5) screen 10' 493'
(length) (depth to top)
2" stainless steel
(size) (material)
- (6) pump 1 HP 10 gpm
(HP) (yield gpm)
electric
(type power)
- (7) electric log no
(yes or no)
(organization running log)
- (8) how well bottom plugged back
wash valve

description of formations encountered	from	to
Red Clay	0	20
White Clay	20	62
Blue Clay	62	114
Silt & white sand	114	188
Blue Clay	188	212
fine blue sand	212	293
Blue Clay	293	345
Blue Sand	345	350
Blue Clay	350	415
Blue Sand	415	493


CODED



DRILLERS REMARKS: Extra
Coarse Sand

If well telescopes please sketch and show depths.

GROUND LEVEL

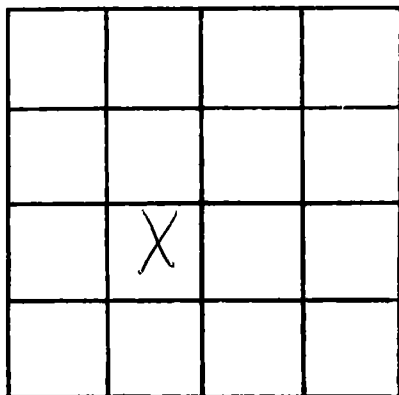

SECTION 26

Please indicate well location X.

ADDITIONAL INFORMATION

If more than one screen, show locations of each on sketch.