

Harrison
G 93
9-67

MISSISSIPPI
 BOARD OF WATER COMMISSIONERS
 416 North State Street
 Jackson, Mississippi 39201


CODED

WATER WELL DRILLERS LOG

Sept. 13 1967 M & B Drilling Co. Harrison
 date well completed firm name county well located

| LANDOWNER: <u>George Cunningham</u> | description of formations encountered | from | to |
|--|--|------|-----|
| P.O. <u>Box Lyman, Miss.</u> | | | |
| <u>Old Highway 49</u> (mailing address) | Surface Clay | 0 | 15 |
| WELL LOCATION: sec. <u>19</u> T <u>6</u> N R <u>11</u> E S W | Red Clay | 15 | 32 |
| miles <u>1.4</u> (distance) of <u>Lyman</u> (nearest town) | White Clay | 32 | 37 |
| WELL PURPOSE: <u>Home</u> (home, irrigation, municipal, industrial) | Sand & Clay Breaks | 37 | 45 |
| WELL COMPLETION DATA: | Brown Sand | 45 | 95 |
| (1) diameter (inches) <u>2"</u> | White Clay & Sand | 95 | 110 |
| (2) total depth (feet) <u>370</u> | White Clay | 110 | 125 |
| (3) static water level (feet) <u>4/3</u> below top of ground. | Blue Clay | 125 | 135 |
| (4) casing <u>PVC</u> <u>354</u> (material) (depth) | Black Clay | 135 | 138 |
| <u>2"</u> (size) if telescope see back. | Grey Clay | 138 | 143 |
| (5) screen <u>10 ft</u> <u>354</u> (length) (depth to top) | Sand | 143 | 147 |
| <u>2"</u> (size) <u>PVC Sand Pac</u> (material) | Dark Grey Clay | 147 | 170 |
| (6) pump <u>1</u> <u>10</u> (HP) (yield gpm) | Sand & Clay Breaks | 170 | 184 |
| <u>270 Volt 1Ø</u> (type power) | Blue Clay | 184 | 210 |
| (7) electric log <u>No</u> (yes or no) | Clay & Sand Breaks | 210 | 250 |
| (organization running log) | Black Organic Material & Wood & Leaves | 250 | 260 |
| (8) how well bottom plugged <u>PVC Cap</u> | Blue Clay | 260 | 285 |
| DRILLERS REMARKS: | Sand | 285 | 310 |
| | Blue Clay | 310 | 337 |
| | Coarse Grey Sand | 337 | 364 |
| | Blue Clay | 364 | + |

CODED

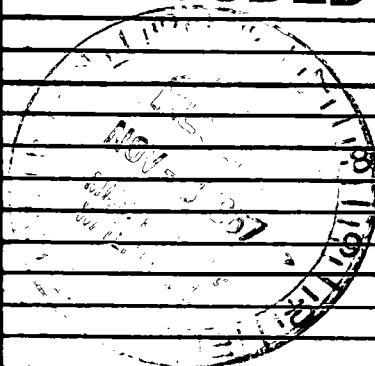

If well telescopes please sketch and show depths.

GROUND LEVEL

| | | | |
|--|--|--|---|
| | | | |
| | | | |
| | | | |
| | | | X |

SECTION 19

Please indicate well location X.

ADDITIONAL INFORMATION

If more than one screen, show locations of each on sketch.