

Harrison
G 9A
10-67

MISSISSIPPI
BOARD OF WATER COMMISSIONERS
416 North State Street
Jackson, Mississippi 39201

CODED

WATER WELL DRILLERS LOG

10-11 1967 date well completed
Switzer Well Co. firm name
Harrison county well located

LANDOWNER: Ross Ikey

description of formations encountered	from	to
clay	0	4
sand	4	16
clay	16	43
clay + sand	43	63
fine sand	63	84
band	84	94
clay	94	145
clay + sand	145	164
sand	164	172
clay	172	222
clay + sand	222	269
clay	269	329
clay + sand	329	368
sand	368	377
clay	377	397
fine sand	397	405
band	405	410
clay + sand	410	425
clay	425	430
fine sand	430	446
good sand	446	490

1/4 mile out on the North side of John Clarke Road
Gulfport Miss. (mailing address)

WELL LOCATION:
sec. 32 T 6 S R. 11 E W
6 miles N of GULFPORT
(distance) (direction) (nearest town)

WELL PURPOSE: Home
(home, irrigation, municipal, industrial)


WELL COMPLETION DATA:

- (1) diameter (inches) 2
- (2) total depth (feet) 490
- (3) static water level (feet) 38 below top of ground.
- (4) casing gal. steel 480' (material) (depth)
2" if telescope see back. (size)
- (5) screen 10' 480' (length) (depth to top)
8 ga. SS on pipe (size) (material)
- (6) pump 1/2 8.5 (HP) (yield gpm)
electric (type power)
- (7) electric log No (yes or no)
- (organization running log)

(8) how well bottom plugged Back pressure valve


DRILLERS REMARKS:

CODED

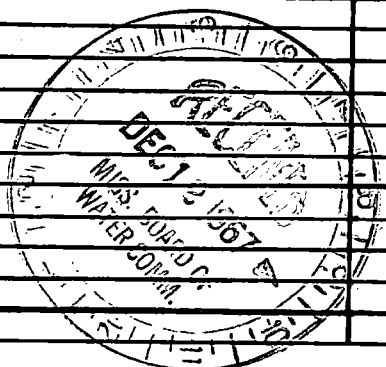

If well telescopes please sketch and show depths.

GROUND LEVEL

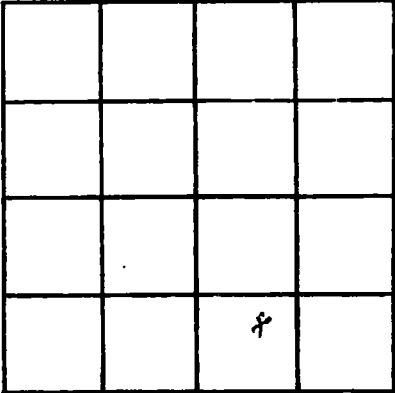

SECTION 32

Please indicate well location X.

ADDITIONAL INFORMATION

If more than one screen, show locations of each on sketch.