

Harrison
G 95
10-67

MISSISSIPPI
BOARD OF WATER COMMISSIONERS
416 North State Street
Jackson, Mississippi 39201

CODED

WATER WELL DRILLERS LOG

10-13 1967 date well completed
Switzer, Skell Co. firm name
Harrison county well located

LANDOWNER: Norman Boyd

description of formations encountered

from to

Route 2 Box 493

clay

0 9

Gulfport, Miss.
(mailing address)

sand

9 21

WELL LOCATION:

sec. 31 T. 6 R. 11 S. W
6 miles N of GULFPORT
(distance) (direction) (nearest town)

clay

21 53

clay + sand streaks

53 73

sand

73 83

clay

83 104

clay + sand streaks

104 125

clay

125 141

sand

141 145

WELL PURPOSE: Home
(home, irrigation, municipal, industrial)

fair sand

145 165

good sand

165 184

WELL COMPLETION DATA:

- (1) diameter (inches) 2
(2) total depth (feet) 184
(3) static water level (feet) 32 below top of ground.

- (4) casing gal. steel 174'
(material) (depth)
2"
(size) if telescope see back.

- (5) screen gal. steel 174'
(length) (depth to top)
10 ga. SS on pipe
(size) (material)

- (6) pump 1/2 8.5
(HP) (yield gpm)
electric
(type power)


- (7) electric log No
(yes or no)

(organization running log)

- (8) how well bottom plugged Back pressure valve

DRILLERS REMARKS:

CODED

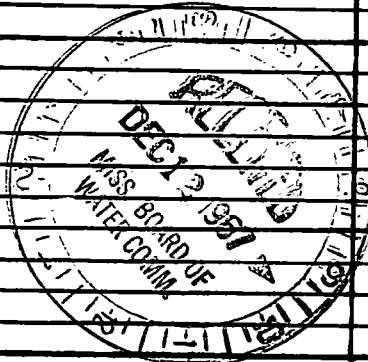

If well telescopes please sketch and show depths.

GROUND LEVEL

			X

SECTION 31

Please indicate well location X.

ADDITIONAL INFORMATION

If more than one screen, show locations of each on sketch.