

Harrison  
 G 96  
 12-67

MISSISSIPPI  
 BOARD OF WATER COMMISSIONERS  
 416 North State Street  
 Jackson, Mississippi 39201

**CODED**

WATER WELL DRILLERS LOG

12-21 1967 date well completed  
 Better Well Works firm name  
 Harrison county well located

LANDOWNER: International Paper Co.

description of formations encountered	from	to
clay	0	54
sand	54	64
clay	64	232
sand	232	242
clay	242	358
sand	358	388


Pass Christian Miss  
 (mailing address)

WELL LOCATION:  
 sec. 21 T. 6 S. R. 11 E.  
1 miles E of Lyman  
 (distance) (direction) (nearest town)

WELL PURPOSE: Industrial  
 (home, irrigation, municipal, industrial)

- WELL COMPLETION DATA:
- (1) diameter (inches) 2
  - (2) total depth (feet) 388
  - (3) static water level (feet) 46 <sup>below</sup> ~~above~~ top of ground.
  - (4) casing Galv. 378'  
 (material) (depth)  
2"  
 (size) If telescope see back.
  - (5) screen 10' 378'  
 (length) (depth to top)  
2" Stainless Steel  
 (size) (material)
  - (6) pump 1 15  
 (HP) (yield gpm)  
elec  
 (type power)
  - (7) electric log no  
 (yes or no)  
 (organization running log)
  - (8) how well bottom plugged BPOalud

**CODED**

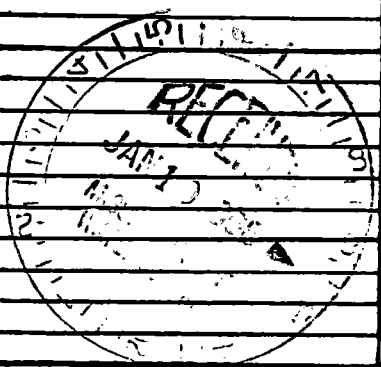

DRILLERS REMARKS:

If well telescopes please sketch and show depths.

0100

GROUND LEVEL

		X	

SECTION 21

Please indicate well location X.

ADDITIONAL INFORMATION

If more than one screen, show locations of each on sketch.