

1/2 mile 10' appearance
bury and 49

Harrison
G97
12-67

MISSISSIPPI
BOARD OF WATER COMMISSIONERS
416 North State Street
Jackson, Mississippi 39201

CODED

WATER WELL DRILLERS LOG

12-21 1967 Switzer Well Co. Harrison
date well completed firm name county well located

LANDOWNER: Herbert Rigney
Route 1
Saucier Miss.
(mailing address)

description of formations encountered	from	to
clay	0	22
fine sand	22	60
clay	60	63
mixed	63	84
fair sand	84	105
good sand	105	125
mixed	125	228
clay	228	269
mixed	269	309
fair sand	309	350
sand	350	364
clay	364	370
mixed	370	380
sand	380	389
good sand	389	423


WELL LOCATION:
sec. 17 T. 6 S. R. 11 W.
2 miles N of LYMAN
(distance) (direction) (nearest town)

WELL PURPOSE: Home
(home, irrigation, municipal, industrial)

WELL COMPLETION DATA:

- (1) diameter (inches) 2
- (2) total depth (feet) 423
- (3) static water level (feet) 33 below above
top of ground.
- (4) casing gal. steel 4 1/2" (material) 413' (depth)
2" (size) If telescope see back.
- (5) screen 10' (length) 4 1/2" (depth to top)
10 ga. (size) SS on pipe (material)
- (6) pump 1 (HP) 800 GPH (yield gpm)
electric (type power)
- (7) electric log No (yes or no)
(organization running log)
- (8) how well bottom plugged Back pressure valve

CODED

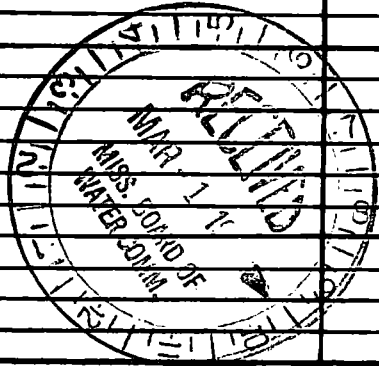

DRILLERS REMARKS:

If well telescopes please sketch and show depths.

GROUND LEVEL

↖			

SECTION 17

Please indicate well location X:

ADDITIONAL INFORMATION

If more than one screen,
show locations of each on sketch.