

Harrison
G 98
1-68

MISSISSIPPI
BOARD OF WATER COMMISSIONERS
416 North State Street
Jackson, Mississippi 39201

CODED

WATER WELL DRILLERS LOG

1-23 1968 date well completed
Sutter Well Works firm name
Harrison county well located

LANDOWNER: JAMES SCOTT

description of formations encountered

from to

Box 230

LYMAN, Miss.
(mailing address)

Clay
Sand
Clay
Sand

0 136
136 141
141 426
426 451

WELL LOCATION:

sec 29 T 6 S R 11 W
1 miles SW of Lyman
(distance) (direction) (nearest town)


WELL PURPOSE: Home
(home, irrigation, municipal, industrial)

WELL COMPLETION DATA:

- (1) diameter (inches) 2
- (2) total depth (feet) 451
- (3) static water level (feet) 50 below top of ground
- (4) casing galv. 441' (material) (depth)
2" (size) if telescope see back.
- (5) screen 10' 441' (length) (depth to top)
2" stainless steel (size) (material)
- (6) pump 1/2 10 (HP) (yield gpm)
elec (type power)
- (7) electric log no (yes or no)
(organization running log)
- (8) how well bottom plugged B.P. Valve

CODED

DRILLERS REMARKS:

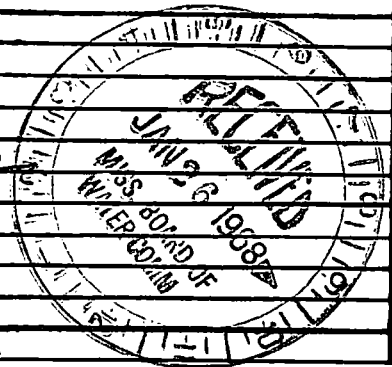

If well telescopes please sketch and show depths.

GROUND LEVEL

		X	

SECTION 29

Please indicate well location X.

ADDITIONAL INFORMATION

If more than one screen, show locations of each on sketch.