

HARRISON

G 99

2-68

MISSISSIPPI
 BOARD OF WATER COMMISSIONERS
 416 North State Street
 Jackson, Mississippi 39201

CODED

WATER WELL DRILLERS LOG

2-9 1968
date well completed

Little Well Works
firm name

Harrison
county well located

LANDOWNER: CHAS. FAIRLEY

Lyman,
Miss.
(mailing address)

description of formations encountered

from to

Clay	0	20
Sand	20	45
Clay	45	103
Sand	103	113
Clay - sand streaks	113	420
Sand	420	508

WELL LOCATION:

sec. 22 T 6 S R 11 E
2 miles E of Lyman
(distance) (direction) (nearest town)

WELL PURPOSE: home
(home, irrigation, municipal, industrial)

WELL COMPLETION DATA:

- (1) diameter (inches) 2
- (2) total depth (feet) 508
- (3) static water level (feet) 56 ~~50~~ Below top of ground.
- (4) casing galv., 498'
(material) (depth)
2" If telescope see back.
(size)
- (5) screen 10', 498'
(length) (depth to top)
2", Stainless Steel
(size) (material)
- (6) pump Unknown
(HP) (yield gpm)


CODED

(type power)
(7) electric log no
(yes or no)

(organization running log)

(8) how well bottom plugged B.P. Value

DRILLERS REMARKS:

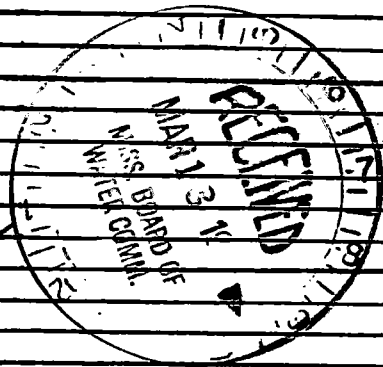

If well telescopes please sketch and show depths.

GROUND LEVEL

X			

SECTION 22

Please indicate well location X.

ADDITIONAL INFORMATION

If more than one screen, show locations of each on sketch.