

Harrison  
G100  
2-68

MISSISSIPPI  
BOARD OF WATER COMMISSIONERS  
416 North State Street  
Jackson, Mississippi 39201

**CODED**

WATER WELL DRILLERS LOG

Feb. 6 1968 M & B Drilling Co. Harrison  
date well completed firm name county well located

LANDOWNER: Forrest Smith  
P.R.  
Gulfport, Miss.  
(mailing address)

WELL LOCATION:  
sec. 35 T. 6 S. R. 11 W.  
6 1/2 miles N of Gulfport, Miss.  
(distance) (direction) (nearest town)

WELL PURPOSE: Home  
(home, irrigation, municipal, industrial)

WELL COMPLETION DATA:

(1) diameter (inches) 2

(2) total depth (feet) 493

(3) static water level (feet) 22 below top of ground.

(4) casing Galv. Steel, 493  
(material) (depth)

(size) if telescope see back.

(5) screen 10 ft., 493  
(length) (depth to top)

2", Stainless Steel  
(size) (material)

(6) pump 1 HP, 15 gpm  
(HP) (yield/gpm)


270V, 2 stage set  
(type power)

(7) electric log No.  
(yes or no)

(organization running log)

(8) how well bottom plugged Back Wash Valve

description of formations encountered	from	to
Surface Clay	0	15
White Sand	15	25
<del>White</del> Clay - Pink	25	40
White Clay	40	60
Brown Sand	60	80
White Clay	80	105
Sand & Clay Breaks	105	115
White Clay	115	130
Sand & Clay Breaks	130	150
Grey Clay	150	170
Blue Clay	170	215
Sand - Grey	215	220
Blue Clay	220	233
Grey Sand	233	239
Blue Clay	239	255
Fire Sand	255	265
Grey Clay	265	320
Blue Clay	320	410
Sand & Clay Breaks	410	435
Grey Sand	435	495
Still Cutting Sand when Drilling Stopped		
Circulation Loss	180	215

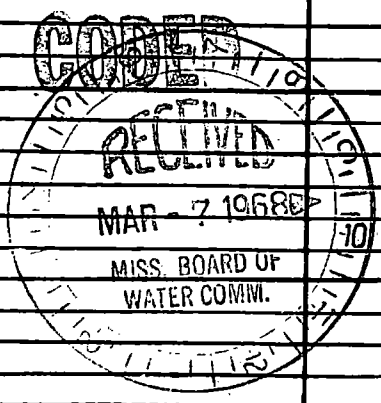

DRILLERS REMARKS:

If well telescopes please sketch and show depths.

GROUND LEVEL

	X		

SECTION 35

Please indicate well location X.

ADDITIONAL INFORMATION

If more than one screen, show locations of each on sketch.