

HARRISON
G 102
3-68

MISSISSIPPI
BOARD OF WATER COMMISSIONERS
416 North State Street
Jackson, Mississippi 39201

CODED

WATER WELL DRILLERS LOG

March 15, 1968 19 R. J. Moore firm name Harrison County county well located
date well completed

LANDOWNER: L. F. Pastes Jr.
Rt. 2 Box 74
Gulfport, Miss.
(mailing address)

description of formations encountered	from	to
Top Soil	0	10
Red & Blue Clay	10	80
White Sand	80	90
Clay Balls	90	120
Silty Sand	120	125
Blue Clay	125	160
Rusty Sand	160	170
Blue Clay	170	284
Blue Sand - Med	284	314
" " - Fine	314	356
Blue Clay	356	398
Blue Sand - Fine	398	419
Coarse Blue Sand	419	500

WELL LOCATION:
sec. 19 T 6 N R. 11 E
12 miles North of Gulfport
(distance) (direction) (nearest town)


WELL PURPOSE: home
(home, irrigation, municipal, industrial)

WELL COMPLETION DATA:

- (1) diameter (inches) 2"
- (2) total depth (feet) 500'
- (3) static water level (feet) 42' ^{below} above top of ground.
- (4) casing 2" galv. 490'
(material) (depth)
 If telescope see back.
(size)
- (5) screen 10' 490'
(length) (depth to top)
2" #8 Stainless Steel
(size) (material)
- (6) pump 1hp
(HP) (yield gpm)
electric
(type power)
- (7) electric log NO
(yes or no)

(organization running log)
- (8) how well bottom plugged back
wash valve

CODED

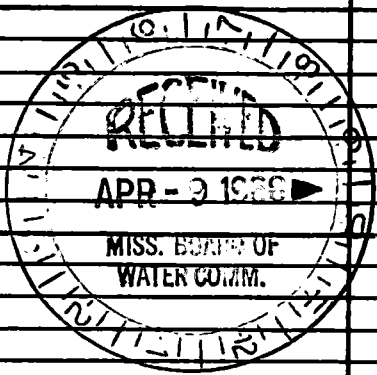

DRILLERS REMARKS: Earlier depth of 314' not satisfactory. Extended to 500' with excellent sand.

