

Harrison
G 105
4-68 CODED

MISSISSIPPI
 BOARD OF WATER COMMISSIONERS
 416 North State Street
 Jackson, Mississippi 39201

CODED

WATER WELL DRILLERS LOG

April 10 date well completed Ed Laddner's Well Works firm name Harrison county well located

LANDOWNER Jimmy Moran
John Clark Rd.
Gulfport, Miss.
 (mailing address)

description of formations encountered	from	to
<u>Yellow</u>		
<u>Clay</u>	<u>0</u>	<u>20</u>
<u>White sand</u>	<u>20</u>	<u>40</u>
<u>Red sand + clay</u>	<u>40</u>	<u>90</u>
<u>Blue clay</u>	<u>90</u>	<u>290</u>
<u>Fine Blue sand</u>	<u>290</u>	<u>330</u>
<u>Blue clay</u>	<u>330</u>	<u>452</u>
<u>Coarse Blue sand</u>	<u>452</u>	<u>458</u>


WELL LOCATION:
 sec 32 T 7 N R 11 E
2 1/2 miles W of Lyman
 (distance) (direction) (nearest town)

WELL PURPOSE: Home
 (home, irrigation, municipal, industrial)

- WELL COMPLETION DATA:
- (1) diameter (inches) 2 inch
 - (2) total depth (feet) 486'
 - (3) static water level (feet) 30 below top of ground.
 - (4) casing Galvanized 4 7/8"
 (material) (depth)
 - 2 in. If telescope see back.
 (size)
 - (5) screen 10 ft. 4 7/8"
 (length) (depth to top)
 - 2 in. 55
 (size) (material)
 - (6) pump 1 10 gal.
 (HP) (yield/gpm)
 - Elec.
 (type power)
 - (7) electric log no
 (yes or no)
 - (organization running log)
 - (8) how well bottom plugged Ball Check

CODED


CODED

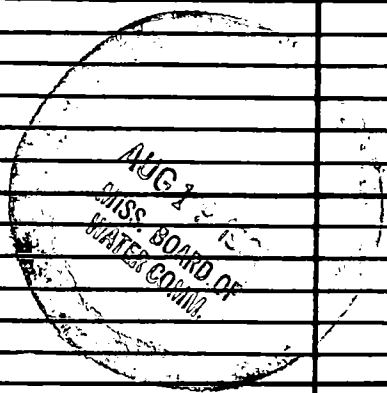

DRILLERS REMARKS:

If well telescopes please sketch and show depths.

GROUND LEVEL

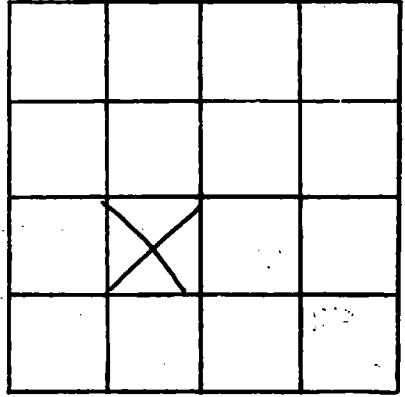

SECTION 32

Please indicate well location X.

ADDITIONAL INFORMATION

If more than one screen, show locations of each on sketch.