

MISSISSIPPI  
BOARD OF WATER COMMISSIONERS  
416 North State Street  
Jackson, Mississippi 39201

**CODED**

**WATER WELL DRILLERS LOG**

Harrison  
G # 107  
8-68

8-6 19 8 R. J. Moore HARRISON  
date well completed firm name county well located

LANDOWNER: Ronnie Page  
SOUTH SWAN RD  
GULFPORT, MISS.  
(mailing address)  
WELL LOCATION:  
sec. 22 T. 6 N R. 11 E  
2 miles E of LYMAN  
(distance) (direction) (nearest town)

description of formations encountered	from	to
SURFACE SOIL	0	12
SURFACE SAND	12	18
Blue Clay	18	220
FINE SAND	220	235
Blue Clay	235	400
SAND + CLAY	400	415
Blue Clay	415	435
Blue SAND (course)	435	484

WELL PURPOSE:  
(home, irrigation, municipal, industrial)

WELL COMPLETION DATA:

- (1) diameter (inches) 2"
- (2) total depth (feet) 484"
- (3) static water level (feet) 32 below above top of ground.
- (4) casing 2" GALV. 474  
(material) (depth)  
         if telescope see back.  
(size)
- (5) screen 10' 474  
(length) (depth to top)  
2" SS  
(size) (material)
- (6) pump 1 620  
(HP) (yield gpm) N  
Elec  
(type power)
- (7) electric log (yes or no)  
          
(organization running log)

**CODED**  
**CODED**

**AUG 13 1968**


MISS. BD. OF  
WATER COMM.

(8) how well bottom plugged BASIC  
WASH VALVE

DRILLERS REMARKS: DD NOT  
DRILL THROUGH SAND

If well telescopes please sketch and show depths.

GROUND LEVEL

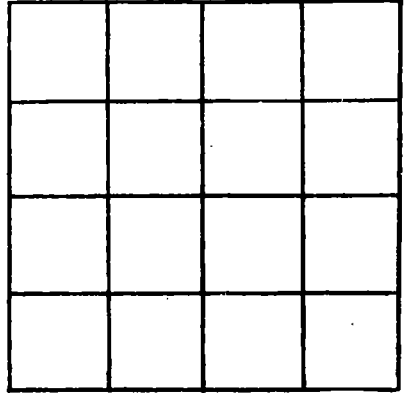

SECTION \_\_\_\_\_

Please indicate well location X.

ADDITIONAL INFORMATION

If more than one screen, show locations of each on sketch.