

3/4 mi. E of Hwy 47
 S. side of N. Swan
 Road

Harrison
 H 108
 6-68
 CODED

MISSISSIPPI
 BOARD OF WATER COMMISSIONERS
 416 North State Street
 Jackson, Mississippi 39201

WATER WELL DRILLERS LOG

CODED

6-4 1968 Switzer Well Co. Harrison
 date well completed firm name county well located

LANDOWNER Alan Blackwell
P.O. Box 2431 Evergreen
Station, Gulfport Miss.
 (mailing address)

WELL LOCATION:
 sec 21 T 6 R 11
 S W
1 miles E of LYMAN
 (distance) (direction) (nearest town)


WELL PURPOSE: Home
 (home, irrigation, municipal, industrial)

WELL COMPLETION DATA:

- (1) diameter (inches) 2
- (2) total depth (feet) 472
- (3) static water level (feet) 53'6" below top of ground.
- (4) casing gal. steel 462'
 (material) (depth)
2"
 (size) if telescope see back.
- (5) screen 10' 462'
 (length) (depth to top)
8 ga. SS on pipe
 (size) (material)
- (6) pump 1 6
 (HP) (yield gpm)
electric
 (type power)
- (7) electric log No
 (yes or no)
 (organization running log)
- (8) how well bottom plugged Back
pressure value

description of formations encountered	from	to
clay	0	10
sand	10	22
mixed	22	84
fine sand	84	126
mixed	126	147
clay	147	167
mixed	167	187
fair sand	187	207
sand	207	217
clay	217	227
mixed	227	269
clay	269	289
mixed	289	351
fine sand	351	383
clay	383	404
fine sand	404	413
fair sand	413	434
good sand	434	472

CODED
CODED

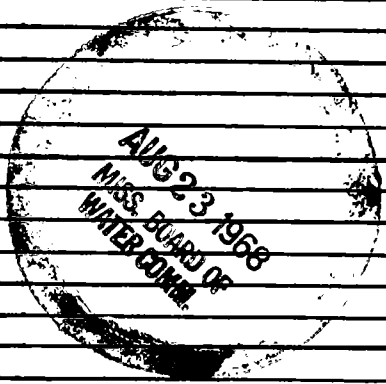

DRILLERS REMARKS:

