

Harrison
 G 107
 9-68

MISSISSIPPI
 BOARD OF WATER COMMISSIONERS
 416 North State Street
 Jackson, Mississippi 39201

CODED

WATER WELL DRILLERS LOG

9-11-1968 date well completed
 68 HATTIESBURG Betane firm name
 HARRISON county well located

LANDOWNER: SARAH CLARK

RT. 2 Box 476
 Gulfport, Miss.
 (mailing address)

description of formations encountered	depth	
	from	to
yellow clay	0	12
red sand + yellow clay	13	48
white sand + clay	49	80
white sand + gravel	81	97
white sand + clay	98	104
white sand + black sand	105	197

WELL LOCATION:


sec. 31 T. 6 S. R. 11 W.
 11 miles NW of Gulfport
 (distance) (direction) (nearest town)

WELL PURPOSE: home
 (home, irrigation, municipal, industrial)

WELL COMPLETION DATA:

- (1) diameter (inches) 2"
- (2) total depth (feet) 197
- (3) static water level (feet) 40' below top of ground.
- (4) casing (material) PVC, (depth) 197'
- (5) screen (size) 2" if telescope see back. (length) 10', (depth to top) 197'
- (6) pump (size) 2" (material) BRONZE (HP) 1 (yield gpm) 625
- (7) electric log (type power) electric (yes or no) NO (organization running log) NO
- (8) how well bottom plugged BACK WASH VALVE

CODED

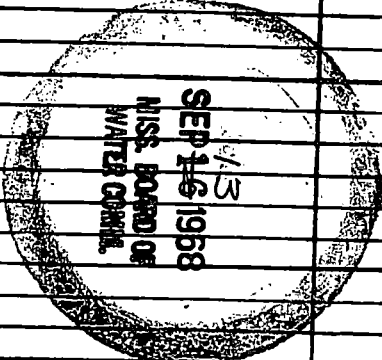

DRILLERS REMARKS:

If well telescopes please sketch and show depths.

GROUND LEVEL

X			

SECTION 31

Please indicate well location X.

ADDITIONAL INFORMATION

Located on John Clark
 Road "A" about 3 miles
 west of Hudson, 49
 South side of track.

If more than one screen, show locations of each on sketch.