

Harrison  
 G 110 CODED  
 9-68

MISSISSIPPI  
 BOARD OF WATER COMMISSIONERS  
 416 North State Street  
 Jackson, Mississippi 39201

**CODED**

WATER WELL DRILLERS LOG

9-13 date well completed  
 18 Mattiesburg Butane firm name  
 Harrison county well located

LANDOWNER: Chifton Holliman Sr.

Route 1 Box 233  
Gulfport, Miss.  
 (mailing address)

WELL LOCATION:

sec. 34 T 6 S R 4 E  
12 miles NE of Gulfport  
 (distance) (direction) (nearest town)

WELL PURPOSE: home  
 (home, irrigation, municipal, industrial)

WELL COMPLETION DATA:


- (1) diameter (inches) 2"
- (2) total depth (feet) 210'
- (3) static water level (feet) 32 below above top of ground.
- (4) casing Galv. 210'  
 (material) (depth)  
2" if telescope see back.  
 (size)
- (5) screen 10' 210'  
 (length) (depth to top)  
2" BRONZE  
 (size) (material)
- (6) pump 1 525  
 (HP) (yield gpm)  
electric  
 (type power)
- (7) electric log NO  
 (yes or no)  
NO  
 (organization running log)
- (8) how well bottom plugged BACK WASH VALVE

description of formations encountered

from to

yellow sand	0	7
white clay	8	11
white sand	12	36
white clay	37	46
black clay	47	74
black chert	75	110
black (sand)	111	130
black clay	131	185
black shell	186	210

**CODED**

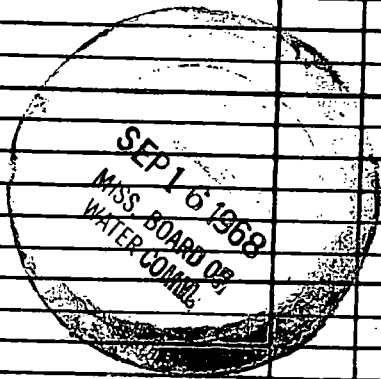

DRILLERS REMARKS:

If well telescopes please sketch and show depths.

*Water*

GROUND LEVEL

*Handwritten notes and sketches on the left side of the page, including a vertical line and various scribbles.*

		X	

SECTION 34

Please indicate well location X.

ADDITIONAL INFORMATION

*North on 49 to Redman  
 Road. Turn (left)  
 Redman Rd; turn north  
 on 3 Rivers Road;  
 go about 2 miles past  
 Pat Adams Apartment  
 turn west onto private  
 back.*

If more than one screen, show locations of each on sketch.