

Harrison  
 G 111 CODED  
 7-18-68

MISSISSIPPI  
 BOARD OF WATER COMMISSIONERS  
 416 North State Street  
 Jackson, Mississippi 39201

**CODED**

WATER WELL DRILLERS LOG

7-18 1968 date well completed  
 Sutter Well Works firm name  
 Harrison county well located

LANDOWNER: Tom Laskowski  
North St.  
Pars Christian Miss.  
 (mailing address)

WELL LOCATION:  
 sec 31 T 6N R 11E  
2 miles W of WUGENT  
 (distance) (direction) (nearest town)


WELL PURPOSE: home  
 (home, irrigation, municipal, industrial)

WELL COMPLETION DATA:

- (1) diameter (inches) 2 x 2 1/2
- (2) total depth (feet) 310
- (3) static water level (feet) 46 below top of ground.
- (4) casing galv. 300'  
 (material) (depth)  
2 x 2 1/2" If telescope see back.  
 (size)
- (5) screen 10' 300'  
 (length) (depth to top)  
2" stainless steel  
 (size) (material)
- (6) pump unknown  
 (HP) (yield gpm)  
 (type power)
- (7) electric log no  
 (yes or no)  
 (organization running log)
- (8) how well bottom plugged BPU

description of formations encountered	from to	
	feet	feet
Clay	0	18
Red sand	18	38
Clay + sand streaks	38	275
sand	275	310

**CODED**

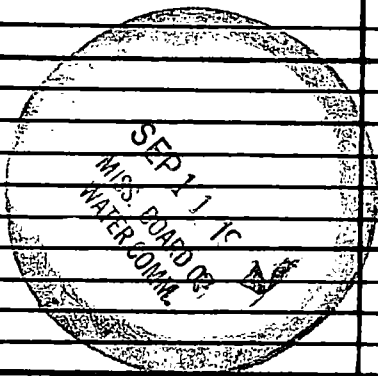

DRILLERS REMARKS: owner furnished casing

If well telescopes please sketch and show depths.

GROUND LEVEL

		X	

SECTION 31

Please indicate well location X.

ADDITIONAL INFORMATION

If more than one screen, show locations of each on sketch.