

CODED

MISSISSIPPI
BOARD OF WATER COMMISSIONERS
416 North State Street
Jackson, Mississippi 39201

WATER WELL DRILLERS LOG

Harrison
G12
10-29-68

Oct. 29 date well completed W. M. B. Drilling Co. firm name Harrison county well located

LANDOWNER: Mabel White
P.O. Box
Hyman, Miss.
(mailing address)

WELL LOCATION:
sec. 19 T. 6 S. R. 11 W.
1/2 miles NW of Hyman
(distance) (direction) (nearest town)

WELL PURPOSE: Home
(home, irrigation, municipal, industrial)

WELL COMPLETION DATA:

- (1) diameter (inches) 2"
 - (2) total depth (feet) 453
 - (3) static water level (feet) 45 below top of ground.
 - (4) casing PVC (material), (depth) 2" (size) if telescope see back.
 - (5) screen 9ft (length), 440 (depth to top) 2" (size), PVC Sand Pac (material)
 - (6) pump 1/2 HP (HP), 10 (yield gpm) 110V 1φ (type power)
 - (7) electric log No. (yes or no)
- (organization running log)
- (8) how well bottom plugged 2" PVC Cap

description of formations encountered	from	to
Surface Clay	0	35
Blue Clay	35	55
Sand & Clay Brooks	55	130
Sand	130	135
Blue Clay	135	142
Sand	142	160
Blue Clay	160	178
Sand - Pine	178	190
Blue Clay	190	330
Sand	330	335
Blue Clay	335	405
Sand	405	455
Still Cutting Sand at	455	

Circulation Loss - 320 - 390

CODED


DRILLERS REMARKS:

DEL 10 1968

MISS. BD. OF WATER COMM.

If well telescopes please sketch and show depths.

GROUND LEVEL

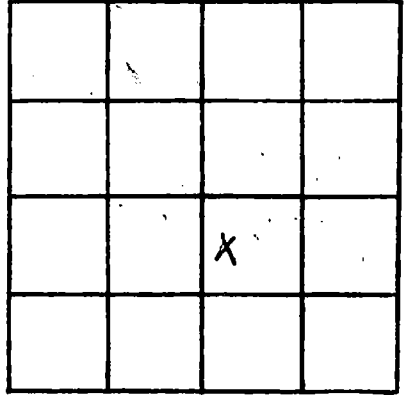

SECTION 19

Please indicate well location X.

ADDITIONAL INFORMATION

If more than one screen, show locations of each on sketch.