

Harrison
G 114
3-13-69

MISSISSIPPI
 BOARD OF WATER COMMISSIONERS
 416 North State Street
 Jackson, Mississippi 39201
WATER WELL DRILLERS LOG

CODED

3-13 1969 Switzer Well Co. Harrison
 date well completed firm name county well located

LANDOWNER: <u>Howard Yocum</u>	description of formations encountered	from	to
<u>Maize Road</u>			
<u>Gulfport, Miss</u> (mailing address)	<u>clay</u>	<u>0</u>	<u>22</u>
	<u>mixed</u>	<u>22</u>	<u>42</u>
	<u>gravel</u>	<u>42</u>	<u>50</u>
	<u>clay</u>	<u>50</u>	<u>62</u>
WELL LOCATION:	<u>mixed</u>	<u>62</u>	<u>83</u>
sec. <u>34</u> T. <u>6</u> R. <u>11</u>	<u>clay</u>	<u>83</u>	<u>104</u>
<u>6</u> miles <u>N</u> of <u>GULFPORT</u>	<u>mixed</u>	<u>104</u>	<u>125</u>
(distance) (direction) (nearest town)	<u>fine sand</u>	<u>125</u>	<u>162</u>
	<u>sand</u>	<u>162</u>	<u>165</u>
WELL PURPOSE: <u>Home</u>	<u>clay</u>	<u>165</u>	<u>204</u>
(home, irrigation, municipal, industrial)	<u>mixed</u>	<u>204</u>	<u>214</u>
WELL COMPLETION DATA:	<u>sand</u>	<u>214</u>	<u>223</u>
(1) diameter (inches) <u>2 x 3</u>	<u>good sand</u>	<u>223</u>	<u>251</u>
(2) total depth (feet) <u>251</u>			
(3) static water level (feet) <u>18</u> below top of ground.			
(4) casing <u>gal steel</u> , <u>236'</u> (material) (depth)			
<u>2 x 3</u> (size) If telescope see back.			
(5) screen <u>15'</u> (length), <u>251'</u> (depth to top)			
<u>8 ga.</u> (size), <u>SS on pipe</u> (material)			
(6) pump <u>1</u> (HP), <u>380</u> (yield gpm)			
<u>electric</u> (type power)			
(7) electric log <u>No</u> (yes or no)			
(organization running log)			
(8) how well bottom plugged <u>back pressure valve</u>			
DRILLERS REMARKS:			

CODED

APR 18 1969


MISS. BD. OF
 WATER COMM.

If well telescopes please sketch and show depths.

GROUND LEVEL

84' OF 3"

162' OF 2"

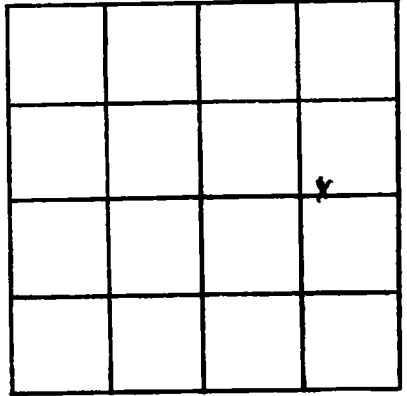

SECTION 34

Please indicate well location X.

ADDITIONAL INFORMATION

If more than one screen, show locations of each on sketch.