

MISSISSIPPI
BOARD OF WATER COMMISSIONERS
416 North State Street
Jackson, Mississippi 39201

WATER WELL DRILLERS LOG

CODED

HARRISON
G 116
6-5-69

6/5/69 1969 Coastal Drilling Harrison
date well completed firm name county well located

LANDOWNER: Wk. King
Rt 1 Box 775
Bishop, Miss.
(mailing address)

WELL LOCATION:
sec 23 T 6 N R 11 E
S W
2 miles W Walnut
(distance) (direction) (nearest town)

WELL PURPOSE: home
(home, irrigation, municipal, industrial)

- WELL COMPLETION DATA:
- (1) diameter (inches) 2"
 - (2) total depth (feet) 420'
 - (3) static water level (feet) _____ below above top of ground
 - (4) casing glass 420' (material) (depth)
(size) If telescope see back.
 - (5) screen 10' (length) (depth to top)
2" (size) SS (material)
 - (6) pump 1 HP 18 (type power) (yield gpm)
 - (7) electric log _____ (yes or no)

(organization running log)

(8) how well bottom plugged
Gravel

DRILLERS REMARKS:
None


description of formations encountered	depth	
	from	to
Red Clay	1	10
Coarse water sand	10	40
fine red sand	40	70
hard clay	70	210
hard clay	210	320
hard clay	320	380
Coarse water sand	380	420

CODED

MISS. WD. WATER CO.

If well telescopes please sketch and show depths.

GROUND LEVEL

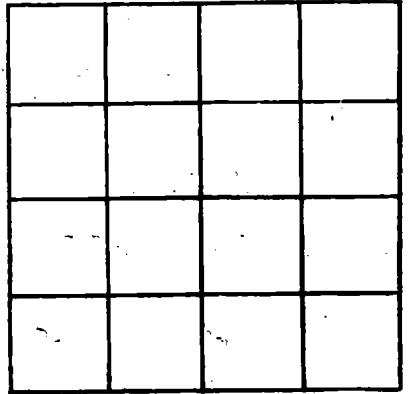

SECTION _____

Please indicate well location X.

ADDITIONAL INFORMATION

If more than one screen, show locations of each on sketch.