

HARRISON
 G 117
 6-9-69

MISSISSIPPI
 BOARD OF WATER COMMISSIONERS
 416 North State Street
 Jackson, Mississippi 39201

CODED

WATER WELL DRILLERS LOG

6/9/69 date well completed
 69 Coastal Drilling firm name
 Harrison county well located

LANDOWNER: W.H. Donald
 Rt 1, Box 256
 Post Office
 (mailing address)

description of formations encountered	from	to
Red Clay	1	10
White Sand	10	30
Blue Clay	30	175
Coarse water sand	175	219

WELL LOCATION:
 sec. 28 T. 6 N. R. 11 E.
 S W
 1/2 mile S of Synon
 (distance) (direction) (nearest town)

WELL PURPOSE: Home
 (home, irrigation, municipal, industrial)

- WELL COMPLETION DATA:
- (1) diameter (inches) 2"
 - (2) total depth (feet) 219'
 - (3) static water level (feet) _____ below above top of ground.
 - (4) casing (material) glass, (depth) 219'
 - (size) _____ If telescope see back.
 - (5) screen 10' (length) (depth to top)
 - 2" (size) SS (material)
 - (6) pump 1/2 (HP) 9 (yield gpm)
 - Ele (type power)
 - (7) electric log _____ (yes or no)

CODED

(organization running log)
 (8) how well bottom plugged good


JUL 31 1969

DRILLERS REMARKS:
 None

MISS. BD. OF
 WATER COMM.

If well telescopes please sketch and show depths.

GROUND LEVEL

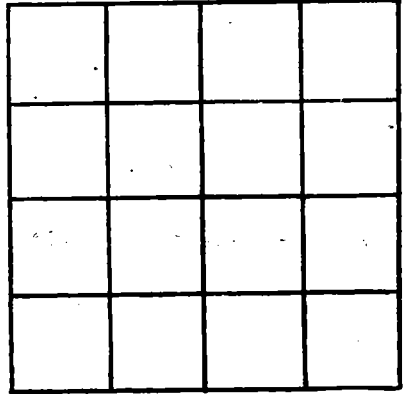

SECTION _____

Please indicate well location X.

ADDITIONAL INFORMATION

If more than one screen, show locations of each on sketch.